

STATE ENGINEER
Salem, Oregon

*Jose
1951*

Well Record

GR- 1775

STATE WELL NO. 39/7W-32C
COUNTY Josephine
APPLICATION NO. GR-1830

OWNER: Alton E. & Edith A. R. Sowell


MAILING ADDRESS: Rt. 1, Box 477

LOCATION OF WELL: Owner's No. _____

CITY AND STATE: Holland, Oregon

NE $\frac{1}{4}$ NW $\frac{1}{4}$ Sec. 32 T. 39 S., R. 7 W., W.M.

Bearing and distance from section or subdivision corner _____

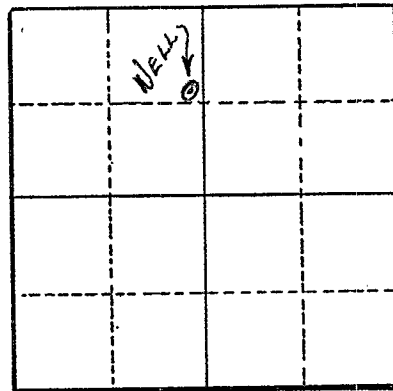

Section 32

Altitude at well 1455'

TYPE OF WELL: Dug Date Constructed 1944

Depth drilled 21' Depth cased 18'

CASING RECORD:

36" concrete tiles

FINISH:

Perforated from 18 to 21 ft.

AQUIFERS:

WATER LEVEL:

PUMPING EQUIPMENT: Type 1 1/2" H.P. 3
Capacity 60 G.P.M.

WELL TESTS:

Drawdown 3 ft. after _____ hours 60 G.P.M.
Drawdown _____ ft. after _____ hours _____ G.P.M.

USE OF WATER Irrigation Temp. _____ °F. _____, 19____

SOURCE OF INFORMATION GR Record

DRILLER or DIGGER _____

ADDITIONAL DATA:

Log _____ Water Level Measurements _____ Chemical Analysis _____ Aquifer Test _____

REMARKS:

Log: Top Soil 0 to 3 ft.
Rocks & gravel 3 to 21 ft.

Irrigation of 10 acres.