

STATE ENGINEER  
Salem, Oregon

*Joel  
1957a*

# Well Record

STATE WELL NO. 39/5W-8C  
COUNTY Josephine  
APPLICATION NO. GR-3060

OWNER: James L. Lathrop MAILING ADDRESS: \_\_\_\_\_

LOCATION OF WELL: Owner's No. \_\_\_\_\_ CITY AND STATE: Williams, Oregon


NE 1/4 NW 1/4 Sec. 8 T. 39 S., R. 5 W., W.M.

Bearing and distance from section or subdivision corner \_\_\_\_\_

Altitude at well \_\_\_\_\_

TYPE OF WELL: Dug Date Constructed 1950

Depth drilled 10 Depth cased \_\_\_\_\_

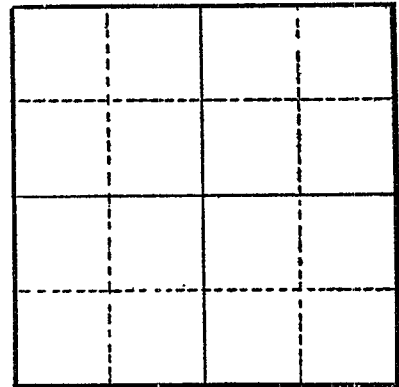

Section 8

## CASING RECORD:

## FINISH:

## AQUIFERS:

## WATER LEVEL:

4 feet

PUMPING EQUIPMENT: Type McCulloch H.P. 5  
Capacity 300 G.P.M.

## WELL TESTS:

Drawdown \_\_\_\_\_ ft. after \_\_\_\_\_ hours \_\_\_\_\_ G.P.M.  
Drawdown \_\_\_\_\_ ft. after \_\_\_\_\_ hours \_\_\_\_\_ G.P.M.

USE OF WATER Irrigation Temp. \_\_\_\_\_ °F. \_\_\_\_\_, 19\_\_\_\_

SOURCE OF INFORMATION GR-3060

## DRILLER or DIGGER

## ADDITIONAL DATA:

Log \_\_\_\_\_ Water Level Measurements \_\_\_\_\_ Chemical Analysis \_\_\_\_\_ Aquifer Test \_\_\_\_\_

## REMARKS: