

STATE ENGINEER
Salem, Oregon

Jose
1959
Well Record

STATE WELL NO. 39/7W-27M(1)
COUNTY Josephine
APPLICATION NO. GR-744

OWNER: Lacey L. Owings

MAILING
ADDRESS:

Route 1, Box 434

LOCATION OF WELL: Owner's No. 1


CITY AND
STATE:

Cave Junction, Oregon

NW $\frac{1}{4}$ SW $\frac{1}{4}$ Sec. 27 T. 39 N. S., R. 7 E. W., W.M.

Bearing and distance from section or subdivision

corner 1220' E & 100' S. of W $\frac{1}{4}$ cor Sec. 27
T. 39 S, R. 7 W.

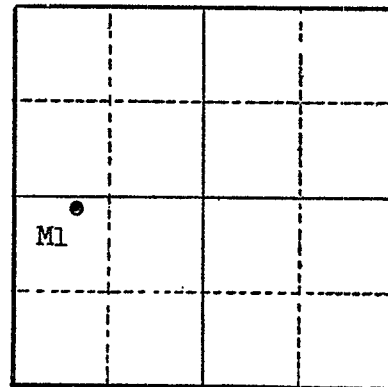

Altitude at well 1580' Interpolated

TYPE OF WELL: Sump Date Constructed April 15, '52

Depth drilled _____ Depth cased _____

Section 27

CASING RECORD:

FINISH:

AQUIFERS:

WATER LEVEL:

PUMPING EQUIPMENT: Type John Deere tractor 4" centrifugal H.P. 25
Capacity 500 G.P.M.

WELL TESTS:

Drawdown _____ ft. after _____ hours _____ G.P.M.

Drawdown _____ ft. after _____ hours _____ G.P.M.

USE OF WATER Irrigation Temp. _____ °F., 19 _____

SOURCE OF INFORMATION GR-744

DRILLER or DIGGER _____

ADDITIONAL DATA:

Log _____ Water Level Measurements _____ Chemical Analysis _____ Aquifer Test _____

REMARKS:

Infiltration trench - 60' long 8' deep minimum, 16' deep
maximum; 10 to 20' wide
Discharge 500 gpm.