

STATE ENGINEER  
Salem, Oregon

*Jose 19602*

# Well Record


STATE WELL NO. 39/7W-32M (1)  
COUNTY Josephine  
APPLICATION NO. GR-197

OWNER: C. J. Moser MAILING ADDRESS: 1500 Lawnridge Ave

LOCATION OF WELL: Owner's No. #3 CITY AND STATE: Grants Pass, Oregon

NW  $\frac{1}{4}$  SW  $\frac{1}{4}$  Sec. 32 T. 39 S., R. 7 W., W.M.

Bearing and distance from section or subdivision corner 2100' N & 1100' E from SW cor. Sec. 32

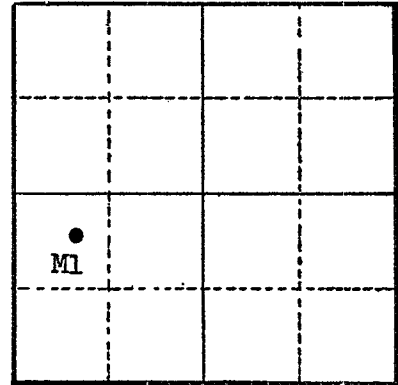

Section 32

Altitude at well 1470' Interpolated

TYPE OF WELL: Infil. trench Date Constructed 7/1/52

Depth drilled 8' Depth cased \_\_\_\_\_

### CASING RECORD:

None

### FINISH:

None

### AQUIFERS:

None

### WATER LEVEL:

4' below land surface

PUMPING EQUIPMENT: Type 8" suction Atlas Diesel H.P. 20  
Capacity 2000 G.P.M.

### WELL TESTS:

Drawdown \_\_\_\_\_ ft. after \_\_\_\_\_ hours \_\_\_\_\_ G.P.M.

Drawdown \_\_\_\_\_ ft. after \_\_\_\_\_ hours \_\_\_\_\_ G.P.M.

USE OF WATER Irrigation 19 acres Temp. \_\_\_\_\_ °F., 19 \_\_\_\_\_

SOURCE OF INFORMATION Registration Statement GR-197

DRILLER or DIGGER \_\_\_\_\_

### ADDITIONAL DATA:

Log No Water Level Measurements \_\_\_\_\_ Chemical Analysis \_\_\_\_\_ Aquifer Test \_\_\_\_\_

### REMARKS: