

STATE ENGINEER  
Salem, Oregon

*Jose*  
*19603* Well Record


STATE WELL NO. 39/7W-32P(1)  
COUNTY Josephine  
APPLICATION NO. GR-197

OWNER: C. J. Moser MAILING ADDRESS: 1500 Lawnridge Ave.

LOCATION OF WELL: Owner's No. #1 CITY AND STATE: Grants Pass, Oregon

SE 1/4 SE 1/4 Sec. 32 T. 39 S., R. 7 W., W.M.

Bearing and distance from section or subdivision  
corner 800' N. & 2300' E. of the SW cor. of  
Sec. 32

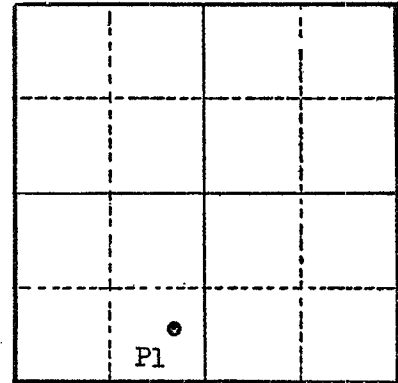

Altitude at well 1470' Interpolated

TYPE OF WELL: Infil. trench Date Constructed 6/1/49

Depth drilled 16' Depth cased

Section 32

CASING RECORD:

None

FINISH:

None

AQUIFERS:

Unknown

WATER LEVEL:

8' below land surface

PUMPING EQUIPMENT: Type 8" suction pump Atlas Diesel H.P. 20

Capacity 2000 G.P.M.

WELL TESTS:

Drawdown ft. after hours G.P.M.

Drawdown ft. after hours G.P.M.

USE OF WATER Irrigation 80 acres Temp. °F., 19

SOURCE OF INFORMATION Registration Statement GR-197

DRILLER or DIGGER

ADDITIONAL DATA:

Log No Water Level Measurements Chemical Analysis Aquifer Test

REMARKS:

Claims 675 gpm