

STATE ENGINEER  
Salem, Oregon

*Jose  
19612*

# Well Record

STATE WELL NO. 39/8W-22Q  
COUNTY JOSEPHINE  
APPLICATION NO. GR-3470

OWNER: Howard E. Salvage

MAILING ADDRESS:

LOCATION OF WELL: Owner's No.


CITY AND STATE:

Cave Junction, Oregon

SW 1/4 SE 1/4 Sec. 22 T. 39 S., R. 8 W., W.M.

Bearing and distance from section or subdivision

corner 1436' N & 127' W of the SW cor. of the SE 1/4 of the SE 1/4 Sec 22

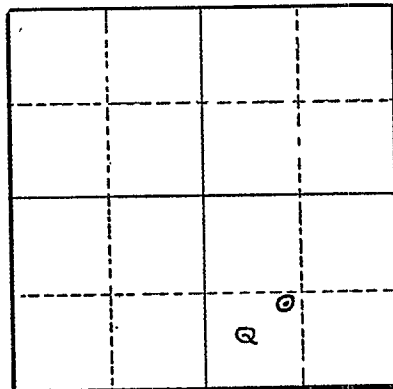

Section 22

Altitude at well

TYPE OF WELL: Drilled Date Constructed

Depth drilled 70' Depth cased

### CASING RECORD:

6-inch

### FINISH:

### AQUIFERS:

### WATER LEVEL:

PUMPING EQUIPMENT: Type Pacific H.P. 3  
Capacity 45 G.P.M.

### WELL TESTS:

Drawdown 10 ft. after 45 hours G.P.M.  
Drawdown ft. after hours G.P.M.

USE OF WATER Irrigation Temp. °F., 19

SOURCE OF INFORMATION GR-3907

DRILLER or DIGGER

### ADDITIONAL DATA:

Log NA Water Level Measurements Chemical Analysis Aquifer Test

### REMARKS: