

STATE ENGINEER
Salem, Oregon

Jose
19614 Well Record

STATE WELL NO. 40/7W-2P(1)
COUNTY Josephine
APPLICATION NO. GR-811

OWNER: D. W. Renfro

MAILING ADDRESS: Route 1, Box 291

LOCATION OF WELL: Owner's No. _____

CITY AND STATE: Cave Junction, Oregon


SE $\frac{1}{4}$ SW $\frac{1}{4}$ Sec. 2 T. 40 N. S., R. 7 E. W., W.M.

Bearing and distance from section or subdivision
corner 1000' N. & 50' W. of the S $\frac{1}{4}$ cor. Sec. 2

Altitude at well 2940

TYPE OF WELL: Trench Date Constructed June 1911

Depth drilled 8' Depth cased _____

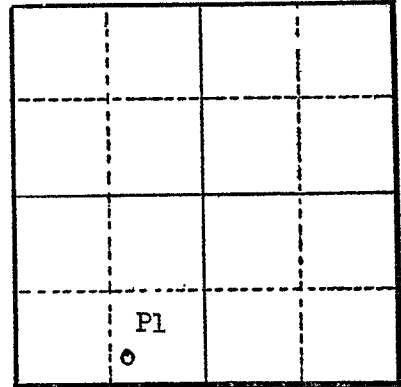

Section 2

CASING RECORD:

FINISH:
Open trench 120' x 40'
Min. depth 4' Max. depth 8'

AQUIFERS:

WATER LEVEL:

4'

PUMPING EQUIPMENT: Type Centrifugal 3" suction 1 $\frac{1}{2}$ " discharge H.P. 4 $\frac{1}{2}$ gas
Capacity 100 G.P.M.

WELL TESTS:

Drawdown _____ ft. after _____ hours _____ G.P.M.
Drawdown _____ ft. after _____ hours _____ G.P.M.

USE OF WATER Irrigation Temp. _____ °F. _____, 19____

SOURCE OF INFORMATION Owner

DRILLER or DIGGER _____

ADDITIONAL DATA:

Log NA Water Level Measurements _____ Chemical Analysis _____ Aquifer Test _____

REMARKS:

Infiltration trench