

STATE ENGINEER  
Salem, Oregon

*Jose  
19615*

# Well Record

STATE WELL NO. 39/8W-22R  
COUNTY ~~KLAMATH~~ JOSEPHINE  
APPLICATION NO. GR-3469

OWNER: Howard E. Salvage


MAILING ADDRESS: P. O. Box 293

LOCATION OF WELL: Owner's No. \_\_\_\_\_

CITY AND STATE: Chiloquin, Oregon

SE 1/4 SE 1/4 Sec. 22 T. 39 S., R. 8 W., W.M.

Bearing and distance from section or subdivision  
corner 369' N & 192 E of the SW cor of the SE 1/4  
of the SE 1/4 Sec 22

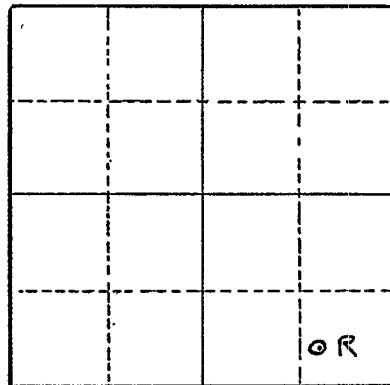

Section 22

Altitude at well \_\_\_\_\_

TYPE OF WELL: Drilled Date Constructed 1947

Depth drilled 65' Depth cased 60'

CASING RECORD:

6-inch

FINISH:

Perforated

AQUIFERS:

WATER LEVEL:

27'

PUMPING EQUIPMENT: Type Pacific Deep Well H.P. 1  
Capacity 15 G.P.M.

WELL TESTS:  
Drawdown 12 ft. after \_\_\_\_\_ hours 50 G.P.M.  
Drawdown \_\_\_\_\_ ft. after \_\_\_\_\_ hours \_\_\_\_\_ G.P.M.

USE OF WATER Irrigation Temp. \_\_\_\_\_ °F. \_\_\_\_\_, 19

SOURCE OF INFORMATION GR-3906  
DRILLER or DIGGER Paquin & Crissman

ADDITIONAL DATA:

Log NA Water Level Measurements \_\_\_\_\_ Chemical Analysis \_\_\_\_\_ Aquifer Test \_\_\_\_\_

REMARKS: