

STATE ENGINEER
Salem, Oregon

Jose
1964

Well Record

STATE WELL NO. 39/8W-22R
COUNTY ~~MACMURDO~~ JOSEPHINE
APPLICATION NO. GR-3468

OWNER: Howard E. Salvage


MAILING ADDRESS: P. O. Box 293

LOCATION OF WELL: Owner's No. _____

CITY AND STATE: Chiloquin, Oregon

SE 1/4 SE 1/4 Sec. 22 T. 39 S., R. 8 W., W.M.

Bearing and distance from section or subdivision
corner 175' N 184'E of the SW Cor of the SE 1/4
of the SE 1/4 Sec 22

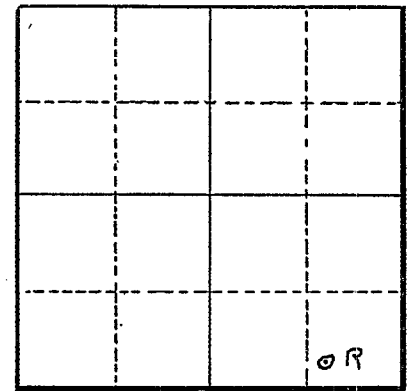

Section 22

Altitude at well _____

TYPE OF WELL: Drilled Date Constructed 1954

Depth drilled 72' Depth cased 70'

CASING RECORD:

8-inch

FINISH:

perforated

AQUIFERS:

WATER LEVEL:

30'

PUMPING EQUIPMENT: Type Berkley Deep Well H.P. 1

Capacity 15 G.P.M.

WELL TESTS:

Drawdown 15 ft. after _____ hours 50 G.P.M.

Drawdown _____ ft. after _____ hours _____ G.P.M.

USE OF WATER Irrigation Temp. _____ °F. _____, 19_____

SOURCE OF INFORMATION GR-3905

DRILLER or DIGGER Paquin & Story

ADDITIONAL DATA:

Log NA Water Level Measurements _____ Chemical Analysis _____ Aquifer Test _____

REMARKS: