

STATE ENGINEER
Salem, Oregon

*2000
1968*
Well Record

STATE WELL NO. 39/8W-21G
COUNTY Josephine
APPLICATION NO. GR-2977

OWNER: F. X. Buchheit

MAILING
ADDRESS: _____

LOCATION OF WELL: Owner's No. _____

CITY AND
STATE: _____


Cave Junction, Oregon

SW $\frac{1}{4}$ NE $\frac{1}{4}$ Sec. 21 T. 39 N. S., R. 8 E. W., W.M.

Bearing and distance from section or subdivision

corner SW Corner, Lot 3, Block D,

Hayden Sub Division.

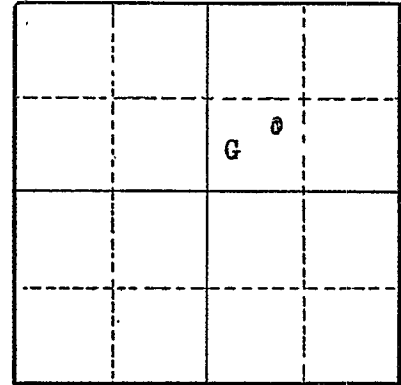

Altitude at well 1350 feet

TYPE OF WELL: Driven Date Constructed May, 1952

Depth drilled 14 1/2 feet Depth cased _____

Section 21

CASING RECORD:

2-inch diameter galvanized pipe on a 2 in screened driving point 3 feet long.

FINISH:

all boughten driving points are screened from 11 1/2 to 14 1/2 feet

AQUIFERS:

WATER LEVEL:

6 feet

PUMPING EQUIPMENT: Type Berkley

H.P. _____

Capacity 30 G.P.M.

WELL TESTS:

Drawdown very little ft. after _____ hours 30 G.P.M.

Drawdown _____ ft. after _____ hours _____ G.P.M.

USE OF WATER Irrigation Temp. _____ °F. _____, 19____

SOURCE OF INFORMATION GR-4105

DRILLER or DIGGER Buchheit and Larry Musil

ADDITIONAL DATA:

Log X Water Level Measurements _____ Chemical Analysis _____ Aquifer Test _____

REMARKS:

river loam

old river bed

water bearing

5
9 1/2 14 1/2