

STATE ENGINEER  
Salem, Oregon

*Jose*  
*19624* Well Record

STATE WELL NO. <sup>405</sup> ~~405~~/7W-62a  
COUNTY Josephine  
APPLICATION NO. GR-3409

OWNER: Clifford E. Pullen


MAILING ADDRESS: Cave Junction ✓

LOCATION OF WELL: Owner's No.

CITY AND STATE: Oregon

NE 1/4 NW 1/4 Sec. 6 T. <sup>405</sup> ~~33~~ R. 7 <sup>E</sup> W., W.M.

Bearing and distance from section or subdivision corner 1550' E. and 700' S.

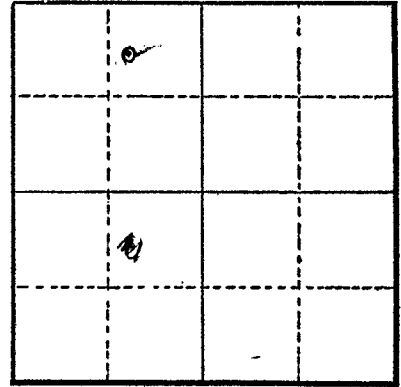

Section .....

Altitude at well .....

TYPE OF WELL: dug ..... Date Constructed 1947

Depth drilled 15' ..... Depth cased .....

CASING RECORD:

FINISH:

AQUIFERS:

WATER LEVEL:

7'

PUMPING EQUIPMENT: Type GE Peerless Impeller Cent. H.P. 5  
Capacity 200 G.P.M.

WELL TESTS:

Drawdown 3 ft. after ..... hours pumping 250 G.P.M.  
Drawdown ..... ft. after ..... hours ..... G.P.M.

USE OF WATER Irrigation Temp. °F. ...., 19

SOURCE OF INFORMATION GR-3158

DRILLER or DIGGER .....

ADDITIONAL DATA:

Log ..... Water Level Measurements ..... Chemical Analysis ..... Aquifer Test .....

REMARKS: