

STATE ENGINEER
Salem, Oregon

JOSE
1947

Well Record


STATE WELL NO. 36/5W-19N(1)
COUNTY Josephine
APPLICATION NO. GR-457

OWNER: O. L. Hogan MAILING ADDRESS: 725 Union Avenue

LOCATION OF WELL: Owner's No. CITY AND STATE: Grants Pass, Oregon

SW 1/4 SW 1/4 Sec. 19 T. 36 N. S., R. 5 E. W., W.M.

Bearing and distance from section or subdivision corner 714' N. & 418' E. from SW cor. Sec. 19

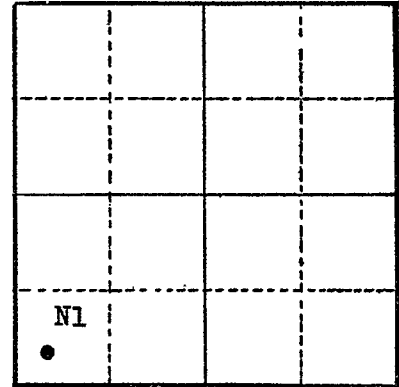

Section 19

Altitude at well 940'

TYPE OF WELL: Drilled Date Constructed 10/27/54

Depth drilled 141 Depth cased

CASING RECORD:

8 inch

FINISH:

AQUIFERS:

WATER LEVEL:

20

PUMPING EQUIPMENT: Type Layne & Bowler H.P. 25

Capacity 450 G.P.M.

WELL TESTS:

Drawdown 40 ft. after hours 330 G.P.M.

Drawdown 100 ft. after hours 450 G.P.M.

USE OF WATER Industrial Temp. °F., 19

SOURCE OF INFORMATION GR-457

DRILLER or DIGGER Paquin & Story, Grants Pass, Oregon

ADDITIONAL DATA:

Log Water Level Measurements Chemical Analysis Aquifer Test

REMARKS:

