NOTICE TO WATER WELL CONTRACTOR The original and first copy of this report are to be


Sled with the

JANS - 9

STATE OF OREGON

STATE ENGINEER, SALEM, OREGONIA TE ENGINEER Pe or print) within 30 days from the date of well completion.


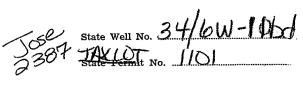

	(A) LOGISTON ON WITH			
(1) OWNER:	(10) LOCATION OF WELL:			
Name Bill GALIDEAU	County Josephine Driller's well number			
Address 140 Old STAge Rd, R.O. Box 596	14 14 Section 10 T. 34-5 R. 6 W. W.M.			
Sunny Valley, Ore	Bearing and distance from section or subdivision corner			
(2) TYPE OF WORK (check):				
New Well Deepening Reconditioning Abandon Reconditioning Abandon				
If abandonment, describe material and procedure in Item 12.	(11) WATER LEVEL: Completed well.			
(3) TYPE OF WELL: (4) PROPOSED USE (check):	Depth at which water was first found 92 ft.			
Rotary Driven Domestic Maintenant Municipal Domestic Maintenant Domestic Maintenant Domestic	Static level 55 ft. below land surface. Date /2/29/7			
Dug Bored Irrigation Test Well Other	Artesian pressure lbs. per squar	e inch.	Date	
CASING INSTALLED: Threaded Welded	(12) WELL LOG: Diameter of well below casing			
6 " Diam. from 0 ft. to 94 ft. Gage 250	Depth drilled 18% ft. Depth of completed well 188 ft.			
ft. toft. Gage	Formation: Describe color, texture, grain size	····	7.0	
ft. Gage	and show thickness and nature of each stratu	m and ac	quifer pe	netrated
DEDECT ACTONS.	with at least one entry for each change of forma position of Static Water Level and indicate prim	tion. Repe	ort each (er-bearir	change ir 10 strata
PERFORATIONS: Perforated? Yes No.	MATERIAL	From	то	SWL
Type of perforator used		From		.5W.D
Size of perforations in. by in.	_C/AY Red	0	9	
perforations from	Clay Ba-	9	56	
perforations from ft. to ft.	-C/Ay WA		00	
(7) SCREENS: Well screen installed? [] Yes X No	De composed BASALT	56	70	_
	7		94	سسوسو
Manufacturer's Name Model No.	FrACTURED BASALT	70	77	99
Diam. Slot size Set from ft. to ft.	RASALT	94	188	63
Diam. Slot size Set from ft. to ft.	- UN JAK	1.7.7		
(8) WELL TESTS. Drawdown is amount water level is				
(8) WELL TESTS: Drawdown is amount water level is lowered below static level	WATER STrata	92	93	3 4 a
Was a pump test made? Yes \(\sigma\) No If yes, by whom?		100-		
Yield: 15 gal./min. with 96 ft. drawdown after / hrs.		12%	134	4 "
" " " " " " " " " " " " " " " " " " "		156	161	8 "
и и и и		1		
Bailer test gal./min. with ft. drawdown after hrs.				
Artesian flow g.p.m.				
perature of water 49 Depth artesian flow encounteredft.	Work started /2/27 19 7/ Complet	ed / 2	129	19 >
(9) CONSTRUCTION:	Date well drilling machine moved off of well	_/2/	129	19 >
	Drilling Machine Operator's Certification	:	•	
Well seal—Material used	This well was constructed under my	direct	t super	vision
Diameter of well bore to bottom of sealin.	Materials used and information reported best knowledge and belief.			
Diameter of well bore below seal	[Signed] J. G. Genst	Date /.	2-2	3 19 7
Number of sacks of cement used in well sealsacks	(Drilling Machine Operator)			
Number of sacks of bentonite used in well seal sacks	Drilling Machine Operator's License No.	/I.	<i>U</i>	
Brand name of bentonite	Water Well Contractor's Certification:			
Number of pounds of bentonite per 100 gallons	This well was drilled under my jurisd	liction a	nd this	report i
of water lbs./100 gals.	true to the best of my knowledge and belief.			
Was a drive shoe used? Yes 🗆 No Plugs Size: location ft.	Name AF DA QUIM Dril	Ving (·0:	
Did any strata contain unusable water? Yes No	Address/ \$##0			
Type of water? depth of strata	Address	المرين موسوق م	ور المراب	
Method of sealing strata off	[Signed] Cf Durantee	<u> </u>	-	
Was well gravel packed? Yes No Size of gravel:	(Water Well Conft	ractor)		
Gravel placed from ft. to ft.	Contractor's License No. 5.46 Date	12/30		, 19 <i>.7/</i>