

State of Oregon
WATER WELL DRILLERS REPORT

K Ray
KLAM 10752
10752

Page 1 of 1

RECEIVED

JUL - 1 1993

Start Card # 51686

34s/9e/4aa

WATER RESOURCES DEPT.

(1) OWNER:
Name DAVE REED
Address P.O. BOX 336
City CHILOQUIN St OR Zip 97624

(2) TYPE OF WORK: NEW WELL

(3) DRILL METHOD: ROTARY AIR

(4) PROPOSED USE: DOMESTIC

(5) BORE HOLE CONSTRUCTION:
Special Construction Approval: NO Depth of Compl. Well 445
Explosives used Type Amount
HOLE SEAL
Diam. From To Material From To Amount
10" 0 -25 CEMENT 0 -25 20 SACKS
6" -25 -445

Seal placement method C

Backfill: from to Material
Gravel: from to Size

(6) CASINGS/LINER:
Diam. From To Gauge Material Connection
Casing 6" +1 -25 .250 STEEL WELDED

Liner 4 1/2" -7 -445 PLASTIC

Final Location of shoe(s)

(7) PERFORATIONS/SCREENS:
Perforations Method ELECTRIC SAW
Screens Type Material
Slot Tele/pipe
From To Size Number Diam. size Casing/liner
-405 -445 1/8x5 76 4 1/2

(8) WELL TESTS: Minimum testing time is 1 hour
Test type AIR

Yield GPM	Draw-down	Drill stem at	Time
10		-320	1 hr.

Temperature of water 62 Depth Artesian Flow Found
Was water analysis done? NO By whom
Reason for water not suitable for use
Depth of strata 0

(9) LOCATION OF WELL by Tied Description:
County KLANATH Lat. " " Long. " "
Township 34 S Range 9 E
Section 4 NE 1/4 NE 1/4
Tax Lot 600 Lot Block Subdivision
Street Address
13755 WILLIAMSON RIVER RD. CHILOQUIN, OR 97624

(10) STATIC WATER LEVEL:
-221 ft. below land surface. Date 06/21/93
Artesian pressure Date

(11) WATER BEARING ZONES:
Depth at which water was first found -330
From To Est Flow Rate SWL
-330 -350 20 GPM -221

(12) WELL LOG:
Material Ground elevation
From To SWL
SOIL 0 1
CLAY & BOULDERS 1 16
GREY & BROWN ROCK 16 110
BLUE SANDSTONE 110 196
BROWN CLAY & ROCK 196 243
GREY ROCK 243 350 221
BLUE CLAY 350 445 221

Date started 06/17/93 Completed 06/21/93


(unbonded) Water Well Certification: I certify that the work I performed on the construction, alteration, or abandonment of this well is in compliance with Oregon well construction standards. Materials used and information reported above are true to my best knowledge and belief.

Signed *[Signature]* MWC Number 1452
Date 06/28/93


(bonded) Water Well Certification: I accept responsibility for the construction, alteration, or abandonment work performed on this well during the construction dates reported above. All work performed during this time is in compliance with Oregon well construction standards. This report is true to the best of my knowledge and belief.

Signed *[Signature]* MWC Number 692
Date 6/18/93

SCALE 1:48000

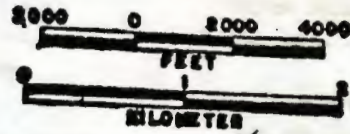

SEE MAP 34 08

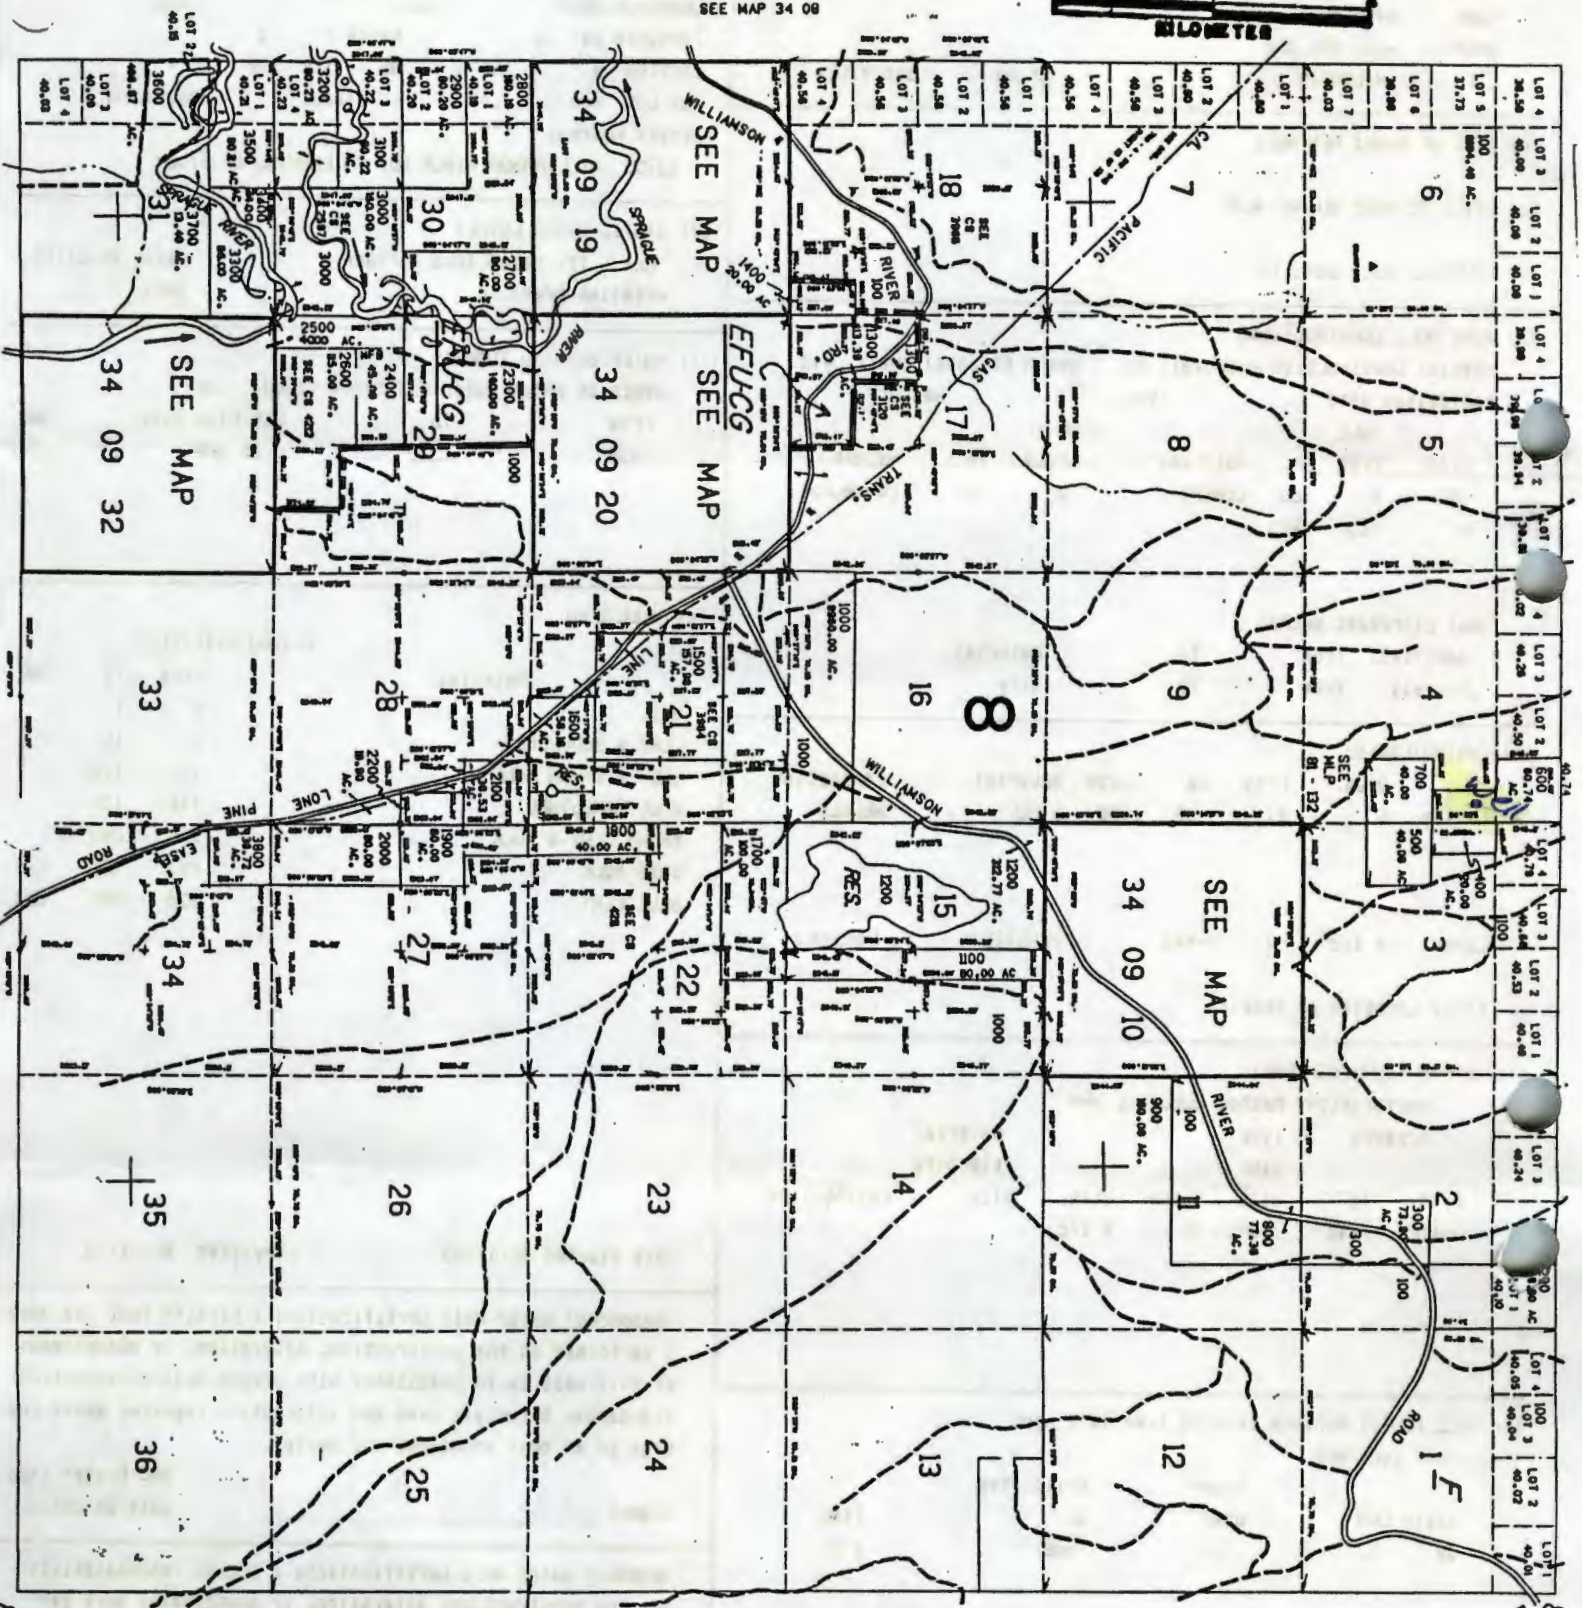

SEE MAP 34 10

INDEX
34 09