

STATE ENGINEER  
Salem, Oregon

*KLAMATH*  
*11641* **Well Record**

STATE WELL NO. 38/9-7M  
COUNTY Klamath  
APPLICATION NO. \_\_\_\_\_

OWNER: M. Vanderhoff


MAILING ADDRESS: \_\_\_\_\_

LOCATION OF WELL: Owner's No. \_\_\_\_\_

CITY AND STATE: \_\_\_\_\_

..... 1/4 ..... 1/4 Sec. .... T. .... N. .... E.  
..... S., R. .... W., W.M.

Bearing and distance from section or subdivision  
corner \_\_\_\_\_

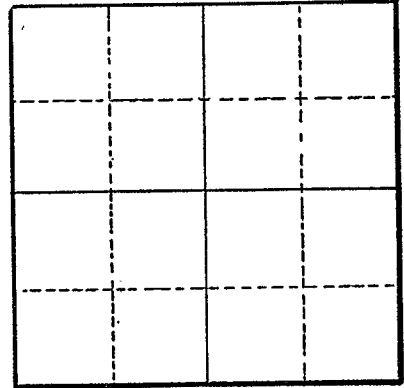

Section \_\_\_\_\_

Altitude at well 4,150

TYPE OF WELL: Drilled Date Constructed \_\_\_\_\_

Depth drilled 192 Depth cased \_\_\_\_\_

CASING RECORD:

8 inch

FINISH:

AQUIFERS: "Gravel"

WATER LEVEL:

12 feet below land surface in 1946

PUMPING EQUIPMENT: Type Turbine H.P. \_\_\_\_\_

Capacity 25 G.P.M.

WELL TESTS:

Drawdown ..... ft. after ..... hours ..... G.P.M.

Drawdown ..... ft. after ..... hours ..... G.P.M.

USE OF WATER Domestic Temp. .... °F. ...., 19....

SOURCE OF INFORMATION USGS

DRILLER or DIGGER \_\_\_\_\_

ADDITIONAL DATA:

Log ..... Water Level Measurements ..... Chemical Analysis ..... Aquifer Test .....

REMARKS:

Supplies motel, restaurant, and service station.  
Calcium carbonate (hardness) 48 p.p.m.  
Chloride 6 p.p.m.