

STATE ENGINEER
Salem, Oregon

*KLAM
11796*

OBSERVATION WELL
Well Record


STATE WELL NO. 34/7-9B (1)
COUNTY Klamath
APPLICATION NO. _____

OWNER: State of Oregon
Collier State Park MAILING ADDRESS: _____

LOCATION OF WELL: Owner's No. _____ CITY AND STATE: _____

NW 1/4 NE 1/4 Sec. 9 T. 34 S., R. 7 XX E. XX, W.M.

Bearing and distance from section or subdivision corner _____

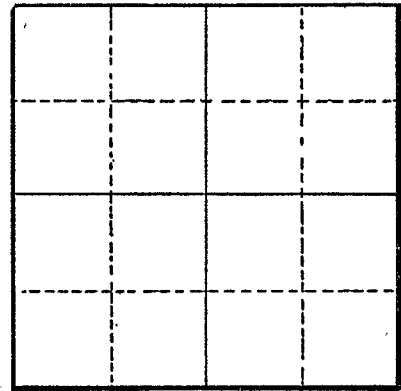

Section 9

Altitude at well 4190

TYPE OF WELL: Dr. Date Constructed _____

Depth drilled 221 Depth cased 42

CASING RECORD: _____

FINISH: _____

AQUIFERS:
Rock

WATER LEVEL:
18.9 (2-16-55)

PUMPING EQUIPMENT: Type Jet H.P. _____
Capacity 15.0 G.P.M.

WELL TESTS:
Drawdown _____ ft. after _____ hours _____ G.P.M.
Drawdown _____ ft. after _____ hours _____ G.P.M.

USE OF WATER Dom. & Public Supply Temp. _____ °F. _____, 19____
SOURCE OF INFORMATION USGS

DRILLER or DIGGER _____

ADDITIONAL DATA:
Log _____ Water Level Measurements X Chemical Analysis _____ Aquifer Test _____

REMARKS: _____

Water Level Record

OWNER: STATE OF OREGON, COLLIER STATE PARK OWNER'S NO. _____

Description of measuring point: 1/2" BOLT THAT IS 0.16' ABOVE TOP OF CASING, 4.84' BELOW L.S.D.

Date	Water Level Feet (above) (below) Land Surface	Remarks	Date	Water Level Feet (above) (below) Land Surface	Remarks
			1-13-61	19.89	
			5-3-61	19.90	
			9-16-61	17.84	
			1-10-62	19.83	

REMARKS: _____

UNITED STATES
DEPARTMENT OF THE INTERIOR
GEOLOGICAL SURVEY

34/7-9B(1)
Klamath

WATER RESOURCES DIVISION

Report Page No. _____
GROUND WATER BRANCH

COUNTY Klamath

STATE Oregon

WATER LEVELS AND ARTESIAN PRESSURES IN OBSERVATION WELLS

34/7-9B1. State of Oregon. Drilled domestic water-table well in basalt, diameter 6 inches, depth 221 feet, cased with steel to 42.5 feet. Land-surface datum is 4,190 feet above msl. MP is 1/2-inch bolt above top of casing, 4.84 feet below lsd.

Highest water level 17.84 below lsd Sept. 16 19 61; lowest 20.34 below lsd June 30 19 55
Records available 1955- Water level Feet below lsd

Date	Water level	Date	Water level	Date	Water level	Date	Water level
1955	—						
FEB. 16	18.74						
JUNE 30	20.34						
1956	—						
Dec 22	18.51						
1958	—						
APR 17	^{b1} 19.48						
1959	—						
SEPT 2	19.49						
1960	—						
JAN 17	^{b1} 19.61						
JUNE 12	^{b1} 21.33						
1961	—						
Jan 13	19.89						
May 3	19.90						
SEPT 16	^{b1} 17.84						

b1 pumped recently

For Official Use Only by The Oregon Water Resources Department:

Received Date:

6-9-05

Well Log Number:

Klam11796

Well Identification Tag #:

L-78771

APPLICATION FOR A WELL IDENTIFICATION TAG

Please print clearly. If shared well see instructions. This is Well # 1 of 1 wells on the property.

LANDOWNER INFORMATION:

Current landowner's name and mailing address:

Oregon Parks & Recreation Department
725 Summer Street NE, Suite C
Salem Oregon 97301-1266

Mail tag and paperwork to: (Real Estate Co. or other party, if not the current landowner):

Henry Mackenroth
Oregon Parks & Recreation Department
725 Summer Street NE, Suite C
Salem, Oregon 97301-1266

Application submitted by (& phone number or e-mail):

Henry Mackenroth, 503-986-0764, henry.mackenroth@state.or.us

Owner at time the well was drilled (if known): _____

WELL LOCATION INFORMATION:

Township #: 34S Range #: 17E Section #: 9 Tax Lot #: 100 County: Klamath

Street Address & City of Well:

Collier State Park, 46000 Highway 97 North, Chiloquin, Oregon

RECEIVED

JUN 09 2005

**WATER RESOURCES DEPT
SALEM, OREGON**

If the property had a different street address in the past, please indicate it, if known:

WELL INFORMATION: (You do not need to complete this section if the well report is attached)

Type of Well (i.e.; domestic, irrigation, commercial, industrial, monitoring, etc.): _____

Date Well Constructed: _____ Well Depth: _____ Casing Diameter: _____

Other Information: _____

Applications can be mailed to: Oregon Water Resources Department – 725 Summer Street N.E., Suite A - Salem, OR 97301-1271 OR fax to 503-986-0902. Applications are processed and tags mailed every Monday morning. **Thank you for participating in Oregon's Well Identification Program!**