

STATE ENGINEER
Salem, Oregon

KLAMATH
1857
12019
Well Record

STATE WELL NO. 38/9-28P(1)
COUNTY Klamath
APPLICATION NO. U-145

OWNER: A. A. Soule


MAILING ADDRESS: P. O. Box 1158

LOCATION OF WELL: Owner's No.

CITY AND STATE: Klamath Falls

SE 1/4 SW 1/4 Sec. 28 T. 38 N. S. R. 9 W., W.M.

Bearing and distance from section or subdivision corner

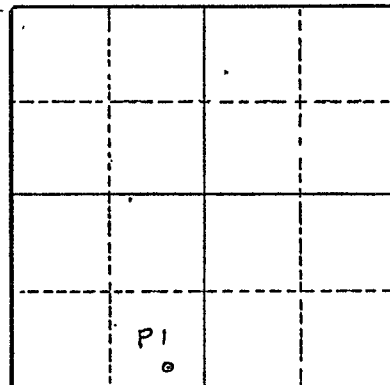

Section 28

Altitude at well

TYPE OF WELL: Drilled Date Constructed 1937

Depth drilled 400 Depth cased

CASING RECORD:

6 inch

FINISH:

AQUIFERS:

WATER LEVEL:

Flows (reported to stand 12' above land surface)

PUMPING EQUIPMENT: Type H.P.
Capacity 50 G.P.M.

WELL TESTS:

Drawdown ft. after hours G.P.M.
Drawdown ft. after hours G.P.M.

USE OF WATER Domestic, irrigation Temp. °F. Hot water well, 19

SOURCE OF INFORMATION U-145

DRILLER or DIGGER

ADDITIONAL DATA:

Log Water Level Measurements Chemical Analysis Aquifer Test

REMARKS:

- OVER -

KLAM 12019

1946 Annual well report.

Mr. Soulé reports that Mr. Vochatzer drilled a well across street and its operation has reduced the artesian pressure on the Soulé well.

1947 Annual well report.

Mr. Soulé reports artesian head had dropped to 3' above land surface because of well across street.

1953 City of Klamath Falls has constructed well approximately 250' from Soule well. This well has interferred with Soulé well.

1958 Medical Center well constructed.

