

STATE ENGINEER  
Salem, Oregon

*KLAM  
HSSA  
12021*

# Well Record

STATE WELL NO. 38/9-28P(2)  
COUNTY Klamath  
APPLICATION NO. U-675

OWNER: City of Klamath Falls MAILING ADDRESS:

LOCATION OF WELL: Owner's No. CITY AND STATE:


SE 1/4 SW 1/4 Sec. 28 T. 38 N. S, R. 9 E, W.M.

Bearing and distance from section or subdivision corner

Altitude at well

TYPE OF WELL: Drilled Date Constructed 1953

Depth drilled 300 Depth cased

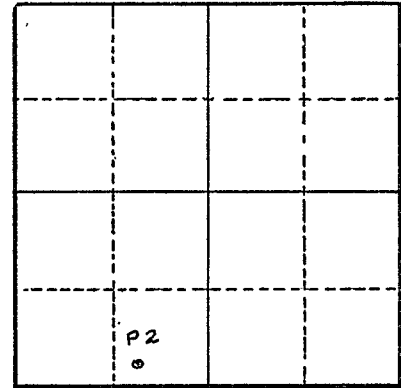

Section 28

### CASING RECORD:

10 inch

### FINISH:

### AQUIFERS:

### WATER LEVEL:

Flows (300 gpm)

PUMPING EQUIPMENT: Type H.P.  
Capacity G.P.M.

### WELL TESTS:

Drawdown ft. after hours G.P.M.  
Drawdown ft. after hours G.P.M.

USE OF WATER Swimming pool Temp. 198 °F., 19

SOURCE OF INFORMATION U-675

DRILLER or DIGGER Wilson Well Drilling

### ADDITIONAL DATA:

Log  Water Level Measurements Chemical Analysis Aquifer Test

### REMARKS:

Annual

