

*KLAMATH*  
*1888*  
*12046*

# Well Record

STATE WELL NO. 38/9-28N6  
COUNTY Klamath  
APPLICATION NO. \_\_\_\_\_

OWNER: Klamath Senior High School


MAILING ADDRESS: \_\_\_\_\_

LOCATION OF WELL: Owner's No. \_\_\_\_\_

CITY AND STATE: \_\_\_\_\_

.....  $\frac{1}{4}$  .....  $\frac{1}{4}$  Sec. .... T. .... N. .... S., R. .... E. .... W., W.M.

Bearing and distance from section or subdivision corner \_\_\_\_\_

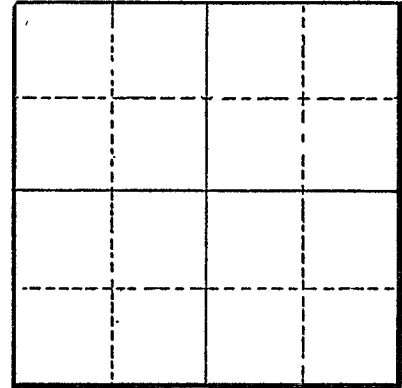

Altitude at well 4,110

Section \_\_\_\_\_

TYPE OF WELL: Drilled Date Constructed \_\_\_\_\_

Depth drilled 240 Depth cased 120 $\frac{1}{2}$

CASING RECORD:

14 inch

FINISH:

AQUIFERS:

Basalt, soft from 223 to 228

WATER LEVEL:

Flowing well, December, 1954

PUMPING EQUIPMENT: Type Turbine H.P. \_\_\_\_\_  
Capacity 350 G.P.M.

WELL TESTS:

Drawdown ..... ft. after ..... hours ..... G.P.M.

Drawdown ..... ft. after ..... hours ..... G.P.M.

USE OF WATER Heating (space) Temp. .... °F. ...., 19....

SOURCE OF INFORMATION USGS

DRILLER or DIGGER \_\_\_\_\_

ADDITIONAL DATA:

Log ..... Water Level Measurements ..... Chemical Analysis ..... Aquifer Test .....

REMARKS:

Used to heat part of school; reportedly flows 200 gpm.