

STATE ENGINEER
Salem, Oregon

KLAM
12084

Well Record

STATE WELL NO. 38/9-29J2
COUNTY Klamath
APPLICATION NO.

OWNER: Balsiger Motors

MAILING

ADDRESS:

LOCATION OF WELL: Owner's No.


CITY AND

STATE:

..... 1/4 1/4 Sec. T. N. E.
..... S., R. W., W.M.

Bearing and distance from section or subdivision

corner

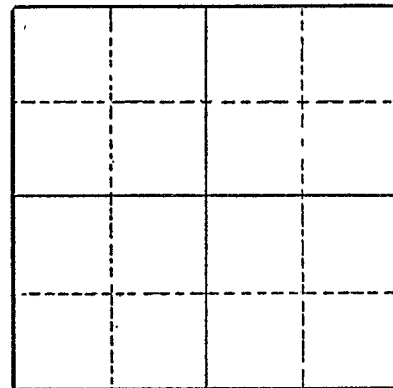

Altitude at well 4,155

TYPE OF WELL: Drilled Date Constructed

Depth drilled 272 Depth cased 31

Section

CASING RECORD:

10 inch

FINISH:

AQUIFERS:

Basalt from 215 to 272

WATER LEVEL:

PUMPING EQUIPMENT: Type H.P.
Capacity G.P.M.

WELL TESTS:

Drawdown ft. after hours G.P.M.

Drawdown ft. after hours G.P.M.

USE OF WATER Heating (space) Temp. °F., 19.....

SOURCE OF INFORMATION USGS

DRILLER or DIGGER

ADDITIONAL DATA:

Log ^X Water Level Measurements Chemical Analysis Aquifer Test

REMARKS:

Drilled for standby in case hot spring (-29J1) goes dry

State Well No. 38/9-29J2
County Klamath
Application No. _____

Owner: Balsiger Motors Owner's No.

[illegible]