

STATE ENGINEER
Salem, Oregon

KLAM
12101

Well Record

STATE WELL NO. 38/9-32G(1)
COUNTY - Klamath
APPLICATION NO. U-89

OWNER: Klamath Heating Co.

MAILING ADDRESS:

LOCATION OF WELL: Owner's No.


CITY AND STATE:

Klamath Falls, Oregon

SW 1/4 NE 1/4 Sec. 32 T. 38 N. S, R. 9 E. W., W.M.

Bearing and distance from section or subdivision

corner Lot 3, Block 75, Klamath Addition to Klamath Falls

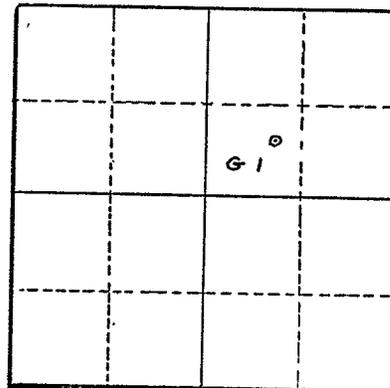

Section 32

Altitude at well

TYPE OF WELL: drilled Date Constructed 1934

Depth drilled 263 Depth cased

CASING RECORD: 12 inch

FINISH:

AQUIFERS:

WATER LEVEL: flows, 65 gpm

PUMPING EQUIPMENT: Type Capacity G.P.M. H.P.

WELL TESTS:

Drawdown ft. after hours G.P.M.

Drawdown ft. after hours G.P.M.

USE OF WATER Industrial Temp. 72 °F., 19

SOURCE OF INFORMATION U-89

DRILLER or DIGGER C. V. Enloe

ADDITIONAL DATA:

Log X Water Level Measurements Chemical Analysis Aquifer Test

REMARKS:

