

NOTICE TO WATER WELL CONTRACTOR

The original and first copy of this report are to be filed with the

STATE ENGINEER, SALEM, OREGON 97310

within 30 days from the date of well completion.

RECEIVED

WATER WELL REPORT

STATE OF OREGON

(Please type or print)

(Do not write above this line)

STATE ENGINEER SALEM, OREGON

KLAM 12/02

State Well No. 38/9-32 F

State Permit No.

(1) OWNER:

Name OREGON WATER CORPORATION

Address 200 N. 7th Street Klamath Falls, Oregon

(2) TYPE OF WORK (check):

New Well # Deepening Reconditioning Abandon

If abandonment, describe material and procedure in Item 12.

(3) TYPE OF WELL:

Rotary Driven Cable Jetted Dug Bored

(4) PROPOSED USE (check):

Domestic Industrial Municipal Irrigation Test Well Other

(5) CASING INSTALLED:

20" Diam. from +1 1/2 ft. to 129 ft. Gage 375

PERFORATIONS:

Perforated? Yes No

Type of perforator used

Size of perforations in. by in. perforations from ft. to ft.

(7) SCREENS:

Well screen installed? Yes No

Manufacturer's Name Type Model No. Diam. Slot size Set from ft. to ft.

(8) WATER LEVEL: Completed well.

Static level ft. below land surface Date Artesian pressure 1/2 lbs. per square inch Date 2/1/68

(9) WELL TESTS:

Drawdown is amount water level is lowered below static level

Was a pump test made? Yes No. If yes, by whom? Valley pump 4200 gal./min. with 70 ft. drawdown after 8 hrs.

(10) CONSTRUCTION:

Well seal—Material used Cement Depth of seal 64' Diameter of well bore to bottom of seal 24 in.

(11) LOCATION OF WELL:

County Klamath Driller's well number #11 SE 1/4 NW 1/4 Section 32 T. 38S R. 9E W.M.

Bearing and distance from section or subdivision corner

Conger Ave.

(12) WELL LOG:

Diameter of well below casing 16

Depth drilled 627 ft. Depth of completed well 620 ft.

Formation: Describe color, texture, grain size and structure of materials; and show thickness and nature of each stratum and aquifer penetrated, with at least one entry for each change of formation.

Table with columns: MATERIAL, From, To, SWL. Contains text 'SEE SHEET ATTACHED'.

Work started 7/20/67 19 Completed 1/30/68 19 Date well drilling machine moved off of well 1/30/68 19

Drilling Machine Operator's Certification:

This well was constructed under my direct supervision. Materials used and information reported above are true to my best knowledge and belief.

[Signed] E.E. Storey Date 2/12/68 (Drilling Machine Operator)

Drilling Machine Operator's License No. 110-115

Water Well Contractor's Certification:


This well was drilled under my jurisdiction and this report is true to the best of my knowledge and belief.

NAME E.E. Storey (Person, firm or corporation) (Type or print)

Address 3831 Hope Klamath Falls, Ore.

[Signed] E.E. Storey (Water Well Contractor)

Contractor's License No. 74 Date 2/12/68 19

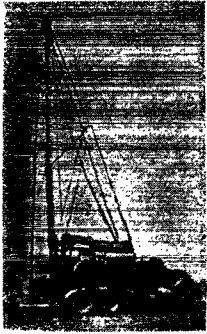


E. E. STOREY

Well Drilling

Phone 884-3990

3831 Hope Street

KLAMATH FALLS, OREGON
97601

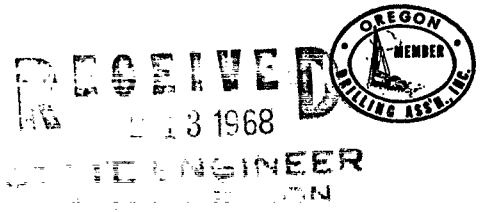

OREGON WATER CORPORATION
200 N. 7TH STREET
KLAMATH FALLS, OREGON

Started 7/20/67

Finished 1/30/68

LOG

0	-	2	black clay and gravel
2	-	56	small boulders and brown clay
56	-	65	brown lava
65	-	68	loose cinders and boulders
68	-	78	red lava
78	-	93	gray shale
93	-	122	brown lava
122	-	137	brown boulders with streaks of cinders
137	-	166	large brown boulders
166	-	172	small boulders
172	-	190	large brown boulders
190	-	278	gray basalt
278	-	367	brown shale
367	-	386	gray shale
386	-	417	brown shale
417	-	427	gray basalt
427	-	452	black basalt
452	-	471	yellow clay
471	-	520	brown sticky shale
520	-	524	brown cinders
524	-	545	brown lava
545	-	553	brown lava and cinder streaks
553	-	556	red sticky shale
556	-	570	black basalt
570	-	578	brown lava
578	-	582	black basalt
582	-	585	gray basalt
585	-	595	gray basalt boulders and caving
595	-	619	brown lava
619	-	627	gray basalt

130' 6" - 20" X .375 casing set at 129'
 Rolled shoe 1 X 6 Cemented inside and outside
 Pumped 4,200 GPM @ 70'
 Temperature 70 degrees
 Artesian flow 70 GPM 1/2 lb. shut-in pressure