

STATE ENGINEER
Salem, Oregon

KLAM
12103

Well Record

STATE WELL NO. 38/9-32F(1)
COUNTY Klamath
APPLICATION NO.

OWNER: Oregon Water Corp.

MAILING
ADDRESS:

LOCATION OF WELL: Owner's No. 6

CITY AND
STATE:

Klamath Falls, Oregon

SE 1/4 NW 1/4 Sec. 32 T. 38 N. S., R. 9 E. W., W.M.


Bearing and distance from section or subdivision
corner

Altitude at well

TYPE OF WELL: drilled Date Constructed 1926

Depth drilled 147 Depth cased 57

Section 32

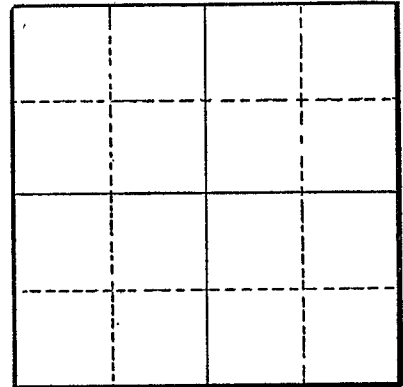

CASING RECORD: 13 in. casing set from 0 to 57 ft.

FINISH: 12 in. open hole from 57 to 131 ft.
10 in. open hole from 131 to 147 ft.

AQUIFERS:

WATER LEVEL:

PUMPING EQUIPMENT: Type H.P.
Capacity G.P.M.

WELL TESTS:
Drawdown ft. after hours G.P.M.
Drawdown ft. after hours G.P.M.

USE OF WATER Temp. °F., 19

SOURCE OF INFORMATION Oregon Water Corp.

DRILLER or DIGGER

ADDITIONAL DATA:

Log Water Level Measurements Chemical Analysis Aquifer Test

REMARKS:

STATE ENGINEER
Salem, Oregon

State Well No. 38/9-32F(1)
County Klamath
Application No.

Well Log

Owner: Oregon Water Corp. Owner's No. 6

Driller: Date Drilled 1926

CHARACTER OF MATERIAL	(Feet below land surface)		Thickness (feet)
	From	To	
Black sandy soil & mud	0	6	6
Chalk rock	6	8	2
Light sandstone or cemented gravel with occasional small boulders of hard rock.	8	23	15
Two inch layer of fine sand at 23 ft.			
Cemented gravel with lots of larger hard boulders	23	29	6
Three inch layer of sand & gravel at 23 ft.			
Chalk rock	29	37	8
Cemented gravel and chalk rock. Layer of sand & gravel at 43 ft.	37	43	6
Sandstone or cemented gravel with occasional boulders layer of coarse sand at 61 ft.	43	61	18
Sandstone or cemented gravel boulders, 3 in. layer of sand at 68 ft.	61	68	7
Sandstone or cemented gravel and boulders. Layer of burnt sand & gravel at 92 ft.	68	92	24
Sand, gravel, & boulders. Layer of burnt sand and gravel at 101 ft.	92	101	9
Sand & gravel, hard boulders, & seamy rock	101	147	46