

STATE ENGINEER
Salem, Oregon

KLAM
12107

Well Record

STATE WELL NO. 38/9-32E(6)
COUNTY Klamath
APPLICATION NO.

OWNER: Oregon Water Corp. MAILING ADDRESS:

LOCATION OF WELL: Owner's No. 7 CITY AND STATE: Klamath Falls


SW 1/4 NW 1/4 Sec. 32 T. 38 N. S, R. 9 E. W., W.M.

Bearing and distance from section or subdivision corner

Altitude at well 4,088

TYPE OF WELL: drilled Date Constructed 1926

Depth drilled 370 Depth cased 73

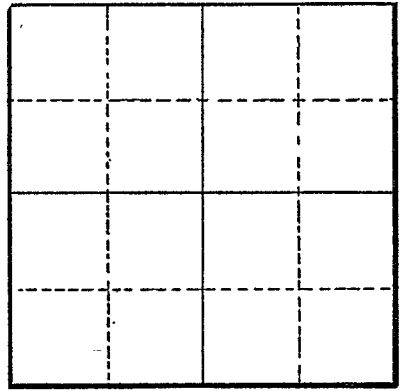

Section 32

CASING RECORD: 13" set to 73 ft.

FINISH: 10" open hole from 73 to 370 ft.

AQUIFERS:

WATER LEVEL:

PUMPING EQUIPMENT: Type centrifugal H.P.
Capacity 1000 G.P.M.

WELL TESTS:
Drawdown ft. after hours G.P.M.
Drawdown ft. after hours G.P.M.

USE OF WATER public supply Temp. °F., 19

SOURCE OF INFORMATION USGS

DRILLER or DIGGER

ADDITIONAL DATA:
Log X Water Level Measurements Chemical Analysis Aquifer Test

REMARKS: City well No. 6
7

STATE ENGINEER
Salem, Oregon

State Well No. 38/9-32E(6)
County Klamath
Application No. _____

Well Log

Owner: Oregon Water Corp. Owner's No. 6

Driller: _____ Date Drilled _____

CHARACTER OF MATERIAL	(Feet below land surface)		Thickness (feet)
	From	To	
Dirt and rock	0	19	19
Chalk rock	19	30	11
Cemented gravel and small rock	30	65	35
Sand and gravel, 8" layer	65	66	1
Sandstone and cemented gravel	66	80	14
Sand, gravel, and hard boulders	80	83½	3½
Red burnt oil sand	83½	92	8½
Black sand, gravel, and boulders	92	103	11
Sandstone	103	110	7
Sand, gravel and hard rocks, very loose form.	110	127	17
Coarse sand	127	128	1
Sand, gravel, and boulders, loose layer			
of sand at 135 ft.	128	135	7
Hard rock and boulders	135	145	10
Layer of sand at 145 ft.			
Hard rock, and boulders, a little sand	145	168	23
Red burnt oil sand	168	168½	½
Lighter colored burnt oil sand	168½	178	9½
Black sand and gravel and hard black rock	178	200	22
Sandstone	200	240	40
Mixed clay and chalky gravel	240	272	32
Clay	272	280	8
Gray porous sandstone	280	286	6
Sand	286	287	1

