

STATE ENGINEER
Salem, Oregon

*KLAM
12141*

Well Record

STATE WELL NO. 38/9-33C3
COUNTY Klamath
APPLICATION NO.

OWNER: Warren Poole


MAILING ADDRESS:

LOCATION OF WELL: Owner's No.

CITY AND STATE:

..... 1/4 1/4 Sec. T. N. E.
..... S., R. W., W.M.

Bearing and distance from section or subdivision corner

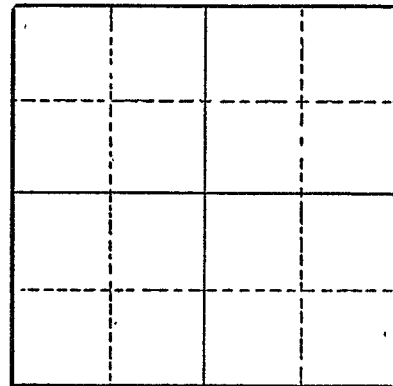

Section

Altitude at well 4.100

TYPE OF WELL: Drilled Date Constructed

Depth drilled 545 Depth cased 300

CASING RECORD:

10 inch

FINISH:

AQUIFERS:

Basalt from 480 to 545

WATER LEVEL:

+8 feet below land surface in 1954

PUMPING EQUIPMENT: Type None H.P.
Capacity G.P.M.

WELL TESTS:

Drawdown ft. after hours G.P.M.

Drawdown ft. after hours G.P.M.

USE OF WATER Heating (space) Temp. °F., 19.

SOURCE OF INFORMATION USGS

DRILLER or DIGGER

ADDITIONAL DATA:

Log Water Level Measurements Chemical Analysis Aquifer Test

REMARKS:

Flows about 10 gpm; well water wasted after passing through house radiators.