


STATE ENGINEER
Salem, Oregon

KLAM 12197
Well Record

STATE WELL NO. 38/10-9M(2)
COUNTY Klamath
APPLICATION NO. U-440

OWNER: Rogers and Stacy
MAILING ADDRESS:
CITY AND STATE: Olens, Oregon

LOCATION OF WELL: Owner's No. NW 1/4 SW 1/4 Sec. 9 T. 38 S. R. 10 W., W.M.
Bearing and distance from section or subdivision corner N 72° 530' from SW cor. NW 1/4 SW 1/4 Section 9

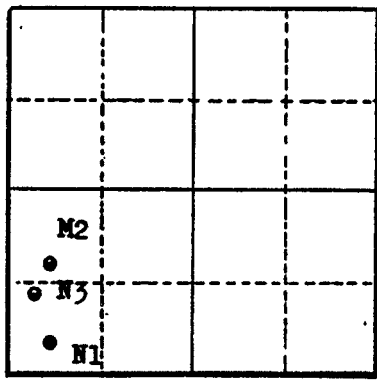

Altitude at well 4190
TYPE OF WELL: Drilled Date Constructed
Depth drilled 294 Depth cased 60'

Section 9

CASING RECORD:

10 inches, 60 feet

FINISH:

AQUIFERS:

Lava rock

WATER LEVEL:

63.45' below land surface, July 20, 1949 Deepened in 1951 water level dropped to 96.44'

PUMPING EQUIPMENT: Type H.P.
Capacity G.P.M.

WELL TESTS:
Drawdown 43 ft. after 2 hours pumping 2300 G.P.M.
Drawdown ft. after hours G.P.M.

USE OF WATER Stock Temp. °F., 19.

SOURCE OF INFORMATION U-440

DRILLER or DIGGER

ADDITIONAL DATA:
Log Water Level Measurements Chemical Analysis Aquifer Test

REMARKS:

Hardness 70 ppm, chloride 7 ppm. Test pumped 260 gpm; agitation of water in well evident when pump not operating; deepened from 208 to 221' in 1951; test pumped at 2,000 gpm; has static level of 90'. Listed as 9M(2) in USGS reports.

STATE ENGINEER
 Salem, Oregon

State Well No. 38/10-9M(2)

County Klamath

Application No. U444

Water Level Record

OWNER: Reger and Stacy OWNER'S NO. _____

Description of measuring point: _____

LSD 4190

USGS

Date	Water Level Feet (above) Foot (below) Land Surface	Remarks	Date	Water Level Feet (above) Foot (below) Land Surface	Remarks
7-19-49	62.55		8-4-50	62.69	
4-14-50	62.64		-11-	62.71	
4-21-50	62.73		-18-	62.72	
4-28-50	62.83		-25-	62.73	
5-5-50	62.85		9-1-50	62.73	
5-12-50	62.90		-8-	62.72	
5-19-50	62.95		-15-	62.71	
5-26-50	62.89		-22-	62.70	
6-2-50	62.87		-29-	62.69	
-9-	62.83		10-6-50	62.67	
16	62.79		-17-	62.66	
23	62.77		20	62.65	
30	62.83		27	62.64	
7-7-50	62.83		8-14-50	62.66	
-11-	62.78		-2-	62.62	
-14-	62.67		-10-	62.53	
-21-	62.67		-17-	62.54	
-28-	62.68		-24-	62.54	

REMARKS: _____

STATE ENGINEER
 Salem, Oregon

State Well No. 38/10-9M/34
 County Klamath
 Application No. 0440

Water Level Record

OWNER: Rogers & Stacy OWNER'S NO. _____

Description of measuring point: _____

USGS

Date	Water Level Foot (below) Land Surface	Remarks	Date	Water Level Foot (below) Land Surface	Remarks

REMARKS: _____

STATE ENGINEER
Salem, Oregon

State Well No. 36/10-9M(4)
County Klamath
Application No. 0440

Water Level Record

OWNER: Reginald & Stacy OWNER'S NO. _____

Description of measuring point: _____

USGS

Date	Water Level Feet (above/ below) Land Surface	Remarks	Date	Water Level Feet (above/ below) Land Surface	Remarks
9-6-51	64.75				
Oct 31		Depth to 221'			
1-4-52	96.44				
7-12-52	94.89				

REMARKS: _____

(1) OWNER:

Name Rogers and Stacy
Address Olene, Oregon

(2) LOCATION OF WELL:

County Klamath Owner's number, if any--
NW 1/4 SW 1/4 Section 9 T. 38 S. R. 10 E. W.M.
Bearing and distance from section or subdivision corner
N. 72° E. - 530 ft. from the SW corner
of the NW 1/4 SW 1/4 of Section 9.

(3) TYPE OF WORK (check):

Well Deepening Reconditioning Abandon
abandonment, describe material and procedure in Item 11.

(4) PROPOSED USE (check):

Domestic Industrial Municipal
gation Test Well Other

(5) TYPE OF WELL:

Rotary Driven
Cable Jetted
Dug Bored

(6) CASING INSTALLED:

12" Diam. from 0 ft. to 60 ft. Gage
" Diam. from ft. to ft. Gage
" Diam. from ft. to ft. Gage

(7) PERFORATIONS:

Perforated? Yes No
Type of perforator used
SIZE of perforations in. by in.
perforations from ft. to ft.
perforations from ft. to ft.
perforations from ft. to ft.
perforations from ft. to ft.

(8) SCREENS:

Well screen installed Yes No
Manufacturer's Name
Model No.
Slot size Set from ft. to ft.
Slot size Set from ft. to ft.

(9) CONSTRUCTION:

Well gravel packed? Yes No Size of gravel:
Gravel placed from ft. to ft.
Was a surface seal provided? Yes No To what depth? ft.
Material used in seal--
Did any strata contain unusable water? Yes No
Type of water? Depth of strata
Method of sealing strata off

(10) WATER LEVELS:

Static level 96.44 ft. below land surface Date 1/4/52
Artesian pressure lbs. per square inch Date

Log Accepted by:

[Signed] (Owner) Date 19

(11) WELL TESTS:

Drawdown is amount water level is lowered below static level
Was a pump test made? Yes No If yes, by whom? Hitchcock
Yield: 2300 gal./min. with 45 ft. drawdown after 2 hrs.
" " " " " "
" " " " " "
" " " " " "
Bailey test gal./min. with ft. drawdown after hrs.
Artesian flow g.p.m. Date
Temperature of water 54 Was a chemical analysis made? Yes No

(12) WELL LOG:

Diameter of well inches.
Depth drilled ft. Depth of completed well ft.
Formation: Describe by color, character, size of material and structure, and show thickness of aquifers and the kind and nature of the material in each stratum penetrated, with at least one entry for each change of formation.

MATERIAL	FROM	TO
Soil	0	20
Lava rock	20	290
Crevice	290	294

U. S. G. S. reports that the water level in this well dropped from about 65 feet to 90 feet when the well was deepened in 1951.

Water has hardness of 70 p.p.m. and chloride content of 7 p.p.m.

Work started 19 Completed 19

(13) PUMP:

Manufacturer's Name Buda
Type: Turbine H.P.

Well Driller's Statement:

This well was drilled under my jurisdiction and this report is true to the best of my knowledge and belief.

NAME So. Oregon Well Drilling Company
(Person, firm, or corporation) (Type or print)
Address
Driller's well number
[Signed] (Well Driller)
License No. Date 19

STATE ENGINEER
Salem, Oregon

KLAM
12197
Klamath Well Record


STATE WELL NO. 38/10-9N2
COUNTY Klamath
APPLICATION NO.

OWNER: George R. Stacy
MAILING ADDRESS:

LOCATION OF WELL: Owner's No. CITY AND STATE:

..... 1/4 1/4 Sec. T. N. E.
..... S., R. W., W.M.

Bearing and distance from section or subdivision
corner

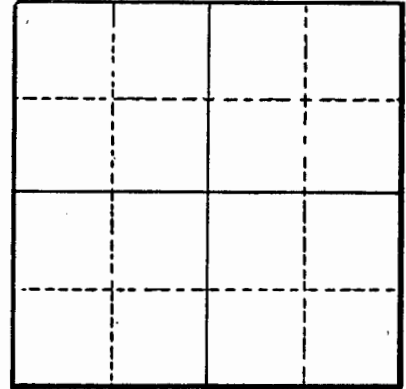

Section

Altitude at well 4,190

TYPE OF WELL: Drilled Date Constructed

Depth drilled 284 Depth cased 60

CASING RECORD:

12 inch

FINISH:

AQUIFERS:

Alluvium; lava rock

WATER LEVEL: 63.45 feet below land surface on 7/20/49
96.44 feet below land surface on 1/ 4/52

PUMPING EQUIPMENT: Type Turbine H.P.
Capacity 1,500 G.P.M.

WELL TESTS:

Drawdown ft. after hours G.P.M.
Drawdown ft. after hours G.P.M.

USE OF WATER Irrigation Temp. °F. , 19

SOURCE OF INFORMATION USGS

DRILLER or DIGGER

ADDITIONAL DATA:

Log Water Level Measurements Chemical Analysis Aquifer Test

REMARKS:

Deepened into basalt bedrock in 1951 and 2,000 gpm capacity obtained.
Calcium carbonate (hardness) 70 p.p.m.
Chloride 7 p.p.m.