

STATE ENGINEER
Salem, Oregon

KLAM
12217

OBSERVATION WELL

Well Record

G-5504

STATE WELL NO. 38/10-22C(1)
COUNTY Klamath
APPLICATION NO. U-319

(Mike Short)

OWNER: L. M. & Lloyd L. Hankins

MAILING

ADDRESS: Route 1

LOCATION OF WELL: Owner's No. 9


CITY AND

STATE: Bonanza, Oregon

NE 1/4 NW 1/4 Sec. 22 T. 38 N. S. R. 10 W., W.M.

Bearing and distance from section or subdivision

corner S 81° 37' E. 2496' from NW cor. Sec. 22

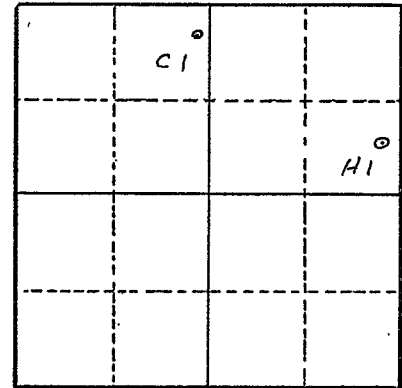

Section 22

Altitude at well

TYPE OF WELL: Drilled Date Constructed

Depth drilled 460 Depth cased 100

CASING RECORD:

18 inch set to 100 feet

FINISH:

AQUIFERS:

Lava rock

WATER LEVEL:

107 feet below land surface

PUMPING EQUIPMENT: Type None

H.P.

Capacity G.P.M.

WELL TESTS:

Drawdown 2.5 ft. after 1 hours pumping 1275 G.P.M.

Drawdown 4.5 ft. after 2 hours pumping 2000 G.P.M.

USE OF WATER Irrigation

Temp. °F. 19

SOURCE OF INFORMATION

DRILLER or DIGGER W. L. Hartley & Son

ADDITIONAL DATA:

Log X Water Level Measurements Chemical Analysis Aquifer Test

REMARKS:

Drawdown 5.5 after 2½ hours pumping 2350 gpm

Drawdown 6.0 after 3 hours pumping 2550 gpm

Drawdown 7.5 after 3½ hours pumping 2750 gpm

Test by Interstate Pump Co. Klamath Falls

State Well No. 38/10-22C(1)
County Klamath
Application No. U-319

Owner: L. M. & Lloyd L. Hankins Owner's No. 9
Driller: W. L. Hartley & Son Date Drilled _____

[illegible]

State Well No. 38/10-22 C(1)

County klamath

Application No. _____

Water Level Record

OWNER: Hankins OWNER'S NO. #9

Description of measuring point:

Lip of Hole on east side of casing which is .6 foot
above LSD.

[illegible]

REMARKS: