

STATE ENGINEER  
Salem, Oregon

KLAM  
12221

OBSERVATION WELL  
Klamath Well Record

STATE WELL NO. 38/10-23F(1)  
COUNTY Klamath  
APPLICATION NO. U-343

OWNER: Gene Carl

MAILING ADDRESS: Route 1


LOCATION OF WELL: Owner's No. 11

CITY AND STATE: Bonanza, Oregon

SE 1/4 NW 1/4 Sec. 23 T. 38 N. S. R. 10 W., W.M.

Bearing and distance from section or subdivision

corner S. 44° 05' 1/2 E. 3470' from NW cor. Sec. 23

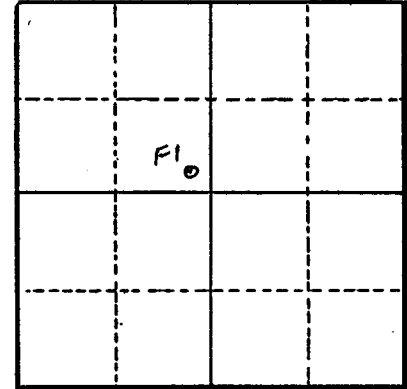

Section 23

Altitude at well

TYPE OF WELL: Drilled Date Constructed

Depth drilled 260 Depth cased 94

CASING RECORD:

18 inch

FINISH:

AQUIFERS:

Water from burnt lava and cinders in bottom of well

WATER LEVEL:

PUMPING EQUIPMENT: Type Turbine, Peerless H.P. 100  
Capacity G.P.M.

WELL TESTS:

Drawdown ft. after hours G.P.M.

Drawdown ft. after hours G.P.M.

USE OF WATER Irrigation Temp. °F. 19

SOURCE OF INFORMATION U-319

DRILLER or DIGGER

ADDITIONAL DATA:

Log  Water Level Measurements Chemical Analysis Aquifer Test


REMARKS:





W Z Hatley

Soil 0-9  
 Chalk 9-200  
 Limestone 200-260

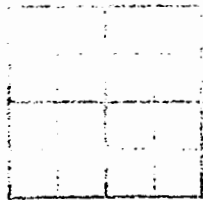


WRD Exp. (GW)  
April 1966

Well No. 38/10-23 F(H) Bdd

WELL SCHEDULE

U. S. DEPT. OF THE INTERIOR GEOLOGICAL SURVEY WATER RESOURCES DIVISION

MASTER CARD ABHarris Owner + 7-30-69  
Record by W. V. Van Source of data Abd. Schild Date 7/15/69 Map

777B No. 10. 100 State Ore. County (or town) Klamath

Latitude: 42 38 10 N Longitude: 122 23 10 W Sequential number: 19

Local well number: 31 32 33 34 35 36 37 38 39 40 41 42 43 44 45 46 47 48 49 50 Other number: B & N

Local use: 31 32 33 34 35 36 37 38 39 40 41 42 43 44 45 46 47 48 49 50 Owner or name: Blogd Goldbok

Ownership: County, Fed Gov't, (M) (N) (P) (S) (W) State Agency, Water Dist 67

Use of water: (A) (B) (C) (D) (E) (F) (H) (I) (M) (N) (P) (R) (S) (T) (U) (V) (W) (X) (Y) (Z) Stock, Instit, Unused, Repressure, Recharge, Desal-P S, Desal-other, Other 68

Use of well: (A) (D) (G) (H) (I) (P) (R) (T) (U) (W) (X) (Z) Anode, Drain, Seismic, Heat Res, Obs, Oil-gas, Recharge, Test, Unused, Withdraw, Waste, Destroyed 69

DATA AVAILABLE: Well data 70 Freq. W/L meas.: Quarterly-State 71 Field aquifer char. 72

Hyd. lab. data: 73

Qual. water data: type: 74

Freq. sampling: 75 Pumpage inventory: yes 76 no: 77 period: 78

Aperture cards: 79

Log data: 80

Log data: 81

Well No. \_\_\_\_\_

Latitude-longitude \_\_\_\_\_

HYDROGEOLOGIC CARD

SAME AS ON MASTER CARD

Physiographic Province: \_\_\_\_\_ Section: \_\_\_\_\_

Drainage Basin: \_\_\_\_\_ Subbasin: \_\_\_\_\_

Topo of well site: (D) depression, stream channel, dunes, (C) flat, (E) hilltop, (R) sink, (K) swamp, (L) offshore, pediment, hillside, terrace, undulating, valley flat

MAJOR AQUIFER: \_\_\_\_\_ system \_\_\_\_\_ series \_\_\_\_\_ aquifer, formation, group \_\_\_\_\_

Lithology: \_\_\_\_\_ Origin: \_\_\_\_\_ Aquifer Thickness: \_\_\_\_\_ ft

Length of well open to: \_\_\_\_\_ ft Depth to top of: \_\_\_\_\_ ft

MINOR AQUIFER: \_\_\_\_\_ system \_\_\_\_\_ series \_\_\_\_\_ aquifer, formation, group \_\_\_\_\_

Lithology: \_\_\_\_\_ Origin: \_\_\_\_\_ Aquifer Thickness: \_\_\_\_\_ ft

Length of well open to: \_\_\_\_\_ ft Depth to top of: \_\_\_\_\_ ft

Intervals Screened: \_\_\_\_\_

Depth to consolidated rock: \_\_\_\_\_ ft Source of data: \_\_\_\_\_

Depth to basement: \_\_\_\_\_ ft Source of data: \_\_\_\_\_

Surficial material: sandy silt Infiltration characteristics: \_\_\_\_\_


Coefficient Trans: \_\_\_\_\_ gpd/ft<sup>2</sup> Coefficient Storage: \_\_\_\_\_

Coefficient Perm: \_\_\_\_\_ gpd/ft<sup>2</sup>; Spec cap: \_\_\_\_\_ gpm/ft; Number of geologic cards: \_\_\_\_\_

Irrig. 36' bene potatoes + 490 acres grain.  
some of grain from drain water.

Grain - once this year - 2<sup>3</sup> preferred  
Qnts - 4M

Potatoes - 3-5 hours and way 4-6 days.

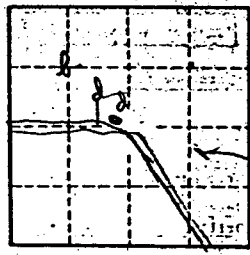

Burner to west = Mike Short

for potatoes uses solid set system 2/32nd  
3 pr. ft/lers - each at 50-60 ft

Owner says about 1 1/2' dd.

well shown on top map.

KLAM 12221

FORM NO 9-1904-A

Observation Well  
SITE NO. 385/10E-23bdd

Recorded by Julie Bouffleur

U.S. DEPT. OF THE INTERIOR  
GEOLOGICAL SURVEY  
WATER RESOURCES DIVISION  
GROUND WATER SITE INVENTORY  
SITE SCHEDULE

Date 6-19-79

Check One  English  Metric Units

GENERAL SITE DATA (0)

Site Ident No 42,150,112,135,49,01 RG Number R=0\* Transaction T=(A) D M V\*  
 Site-Type 2=C D H I M P T (W)\* Data 3=(C) U L M\* Reporting Agency 4=OR00A\*  
 Project No. 5=4741-00200\* District 6=41\* State 7=41\* County (or town) KLAMATH 8=035\*  
 Latitude 9=42:15:01\* Longitude 10=112:35:49\* Lat-Long Accuracy 11=S (F) T M\*  
 Local Number 12=385/10E-23BDD Land Net Loc. 13=SEISE,NW:23,T:38S,R:10E,W\*  
 Location Map 14=SWAN LAKE Scale 15=625,00\*  
 Altitude 16=4200.00\* Method of Measurement 17=A L (M)\* Accuracy 18=20\*  
 Topo Setting 19=D C E (F) H K L Ø P S T U V W\* Hydrologic Unit (OWDC) 20=18,01,020A\*  
 Date of First Construction/Completion 21=0,010,01,1957\* Use of Site 23=A D E G H Ø M P R S T U (W) X Z\*  
 Use of Water 24=A B C D E F H (I) M N P R S T U Y Z\*  
 Secondary Water Use 25=\* Tertiary Use 26=\* Depth of Hole 27=260.00\* Depth of Well 28=260.00\* Source of Depth Data 29=D\*  
 Water Level 30=1,03.45\* Date Measured 31=04/27/1978\* Source 33=5\*  
 Method of Measurement 34=A C A E G H L M R S (T) V Z\*  
 Site Status 37=D F G H Ø P R S T V X Z\*  
 Source of Geohydrologic Data 36=\* Pump Used 35=\* Measuring Point 266=1.00\* Measuring Point Date 267=04/24/1957\*

OWNER IDENTIFICATION (1)

R=158\* T=(A) D M\* Date of Ownership 159#00/00/1962\*  
 Name: Last 161=GOLBEK First 162=LLOYD Middle Initial 163=\*

OTHER SITE IDENTIFICATION NUMBERS (1)

R=189\* T=A D M\* Ident 190# Assigner 191#  
 New Card Same R & T Ident 190# Assigner 191#

SITE VISIT DATA (1)

R=186\* T=(A) D M\* Date of Visit 187#04/24/1957\* Name of Person 188=BARTHOLOMEW\*

FIELD WATER QUALITY MEASUREMENTS (1)

R=192\* T=A D M\* Date 193# / / 194# Geohydrologic Unit 195#  
 Temperature 196#0,0,0,1,0\* Degrees C 197#  
 Conductance 196#0,0,0,9,5\* µMhos 197#  
 Other (STORET) Parameter 198# Value 197#  
 Other (STORET) Parameter 198# Value 197#

FOOT NOTES:

① Source of Data Codes:

S D Ø A R L G Z  
 reporting, driller, owner, other gov't, other logs, geologist, other agency reported,

LAT. LONG COMPUTED  KEYPUNCHED  
 LAT. LONG CHECKED  PRELIM. EDIT  
 FINAL SUBMIT gm

**WELL CONSTRUCTION DATA (1)**

R-58 \* T- A D M \* Entry No 59 #    /    /    \* Date of Construction Completion 60-0010011957 \* Source of Const. Data 64-S \*  
add, delete, modify  
 Name of Contractor/Driller 63- Boranza, Oregon \*  
 Method of Construction 65- A B C D H J P R T V W Z \*  
air, rotary; bored, or augered; tool; dug; hydraulic, rotary; jetted; air-percussion; reverse, rotary; trenching; driven; drive, wash; other  
 Finish 66- C F G H Ø P S T W X Z \* Type of Seal 67- B C G Z \*  
porous, gravel w. concrete; gravel, perf. screen; horizontal, gallery; open, end; perforated, or slotted; screen, sand point; walled, open, hole; bentonite, clay, cement, other grout  
 Bottom of Seal 68-    \* Method of Development 69- A B C J N P S Z \* Number of Hours in Development 70-    \*  
air-lift, bailed, compressed, jetted, none, other, surged, other pump; air pump  
 Special Treatment During Development 71- C D E F H M Z \*  
chemicals, dry ice, explosives, deflocculant, hydrofracturing, mechanical, other

**DIMENSIONS OF THE HOLE CONSTRUCTED (2)**

R-72 \* T- A D M \* Construction Entry No 59 #    /    /    \*  
add, delete, modify  

Top of Hole Segment Below LSD	Bottom of Hole Segment below LSD	Diameter of Hole Segment
<u>73</u> # <u>  </u> / <u>  </u> / <u>  </u> * <u>0.00</u>	<u>74</u> # <u>  </u> / <u>  </u> / <u>  </u> * <u>200.00</u>	<u>75</u> # <u>  </u> / <u>  </u> / <u>  </u> * <u>18.00</u>
<u>73</u> # <u>  </u> / <u>  </u> / <u>  </u> *	<u>74</u> # <u>  </u> / <u>  </u> / <u>  </u> *	<u>75</u> # <u>  </u> / <u>  </u> / <u>  </u> *
<u>73</u> # <u>  </u> / <u>  </u> / <u>  </u> *	<u>74</u> # <u>  </u> / <u>  </u> / <u>  </u> *	<u>75</u> # <u>  </u> / <u>  </u> / <u>  </u> *
<u>73</u> # <u>  </u> / <u>  </u> / <u>  </u> *	<u>74</u> # <u>  </u> / <u>  </u> / <u>  </u> *	<u>75</u> # <u>  </u> / <u>  </u> / <u>  </u> *
<u>73</u> # <u>  </u> / <u>  </u> / <u>  </u> *	<u>74</u> # <u>  </u> / <u>  </u> / <u>  </u> *	<u>75</u> # <u>  </u> / <u>  </u> / <u>  </u> *

New Card for Each Hole Segment Same R, T & Field 59

**CASING SCHEDULE (2)**

R-76 \* T- A D M \* Construction Entry No 59 #    /    /    \*  
add, delete, modify  

Top of Casing Segment Below LSD	Bottom of Casing Segment Below LSD	Diameter of Casing Segment	Casing Material <sup>⑤</sup>	Thickness of Casing
<u>77</u> # <u>  </u> / <u>  </u> / <u>  </u> * <u>0.00</u>	<u>78</u> # <u>  </u> / <u>  </u> / <u>  </u> * <u>94.00</u>	<u>79</u> # <u>  </u> / <u>  </u> / <u>  </u> * <u>18.00</u>	<u>80</u> # <u>  </u> / <u>  </u> / <u>  </u> * <u>S</u>	<u>81</u> # <u>  </u> / <u>  </u> / <u>  </u> * <u>  </u>
<u>77</u> # <u>  </u> / <u>  </u> / <u>  </u> *	<u>78</u> # <u>  </u> / <u>  </u> / <u>  </u> *	<u>79</u> # <u>  </u> / <u>  </u> / <u>  </u> *	<u>80</u> # <u>  </u> / <u>  </u> / <u>  </u> *	<u>81</u> # <u>  </u> / <u>  </u> / <u>  </u> *
New Card for Each Casing With Same R, T & Field 59

**OPENINGS SCHEDULE (2)**

R-82 \* T- A D M \* Construction Entry No 59 #    /    /    \*  
add, delete, modify  

(Openings Data)	(Openings Data)	(Openings Data)
Top of Section Below LSD <u>83</u> # <u>  </u> / <u>  </u> / <u>  </u> *	<u>83</u> # <u>  </u> / <u>  </u> / <u>  </u> *	<u>83</u> # <u>  </u> / <u>  </u> / <u>  </u> *
Bottom of Section Below LSD <u>84</u> # <u>  </u> / <u>  </u> / <u>  </u> *	<u>84</u> # <u>  </u> / <u>  </u> / <u>  </u> *	<u>84</u> # <u>  </u> / <u>  </u> / <u>  </u> *
Type of Openings <sup>⑥</sup> <u>85</u> # <u>  </u> / <u>  </u> / <u>  </u> *	<u>85</u> # <u>  </u> / <u>  </u> / <u>  </u> *	<u>85</u> # <u>  </u> / <u>  </u> / <u>  </u> *
Type of Material <sup>⑦</sup> <u>86</u> # <u>  </u> / <u>  </u> / <u>  </u> *	<u>86</u> # <u>  </u> / <u>  </u> / <u>  </u> *	<u>86</u> # <u>  </u> / <u>  </u> / <u>  </u> *
Diameter of Open Section <u>87</u> # <u>  </u> / <u>  </u> / <u>  </u> *	<u>87</u> # <u>  </u> / <u>  </u> / <u>  </u> *	<u>87</u> # <u>  </u> / <u>  </u> / <u>  </u> *
Width of Opening <u>88</u> # <u>  </u> / <u>  </u> / <u>  </u> *	<u>88</u> # <u>  </u> / <u>  </u> / <u>  </u> *	<u>88</u> # <u>  </u> / <u>  </u> / <u>  </u> *
Length of Opening <u>89</u> # <u>  </u> / <u>  </u> / <u>  </u> *	<u>89</u> # <u>  </u> / <u>  </u> / <u>  </u> *	<u>89</u> # <u>  </u> / <u>  </u> / <u>  </u> *

New Card for Each Open Section With Same R, T and Field 59

**FOOT NOTES:**

① Source of Data Codes:

S D B A R L G Z  
reporting, driller, owner, other gov't, other agency; logs, geologist, other reported

⑤ Casing Material Codes

B C G I M P R S T U W Z  
brick, concrete, galv. wrought, other, iron; PVC or, rock or, steel, tile, metal, wood, other; metal, plastic, stone, steel

⑥ Type of Openings Codes

F L M P R S T W X Z  
fracture, lowered, mesh, perforated, wire, screen, sand, walled, open, other; slotted, wound (unknown), point

⑦ Type of Material Codes for Open Sections

B C G I M P R S T Z  
bronze, concrete, galv. wrought, other, iron; PVC or, stainless, steel, tile, other; iron, iron, metal, plastic, steel



# KLAM 12221

**PRODUCTION DATA (1)**

R = 134 146 \*    T = A D M \*    Entry No 147 #    Date 148 = / / \*  
flowing, pumped    add, delete, modify    month    day    year

Discharge: 150 =    Source of Data 151 = \*  
Method of Measurement 152 = B C E F M O P R T U V W Z \*  
bailer, current, estimated, flume, totaling, orifice, pitot-tube, reported, trajectory, venturi, volumetric, weir, other  
meter

Production Level 153 =    Static Level 154 =    Source of Data 155 = \*    Specific Capacity 272 = \*  
Method of Measurement 156 = A C E G H L M R S T V Z \*    Pumping Period 157 = \*  
airline, calibrated, estimated, pressure, calibrated, geophysical, manometer, reported, steel, electric, calibrated, other  
airline    gauge    pressure    gauge    logs    tape    tape    electric    tape

**LIFT DATA (1)**

R = 42 \*    T = A D M \*    Type of Lift 43 #    Entry No 254 # \*  
add, delete, modify    air, bucket, centrifugal, jet, piston, rotary, submergible, turbine, unknown, other

Pump Intake Setting 44 =    Type of Power 45 = D E G H L N W Z \*  
diesel, electric, gasoline, hand, LP gas, natural, windmill, other gas

Date 38 = / / \*    Horsepower 46 = \*  
month    day    year

**MAJOR PUMP DATA (2)**

R = 47 \*    T = A D M \*    Type of Lift 43 #    Lift Entry No 254 # \*    Manufacturer of Pump 48 = \*  
add, delete, modify

Serial No of Pump 49 =    Name of Power Company 50 = \*  
Power Company Account No 51 =    Power Meter No 52 = \*    Pump Rating 53 = \*  
Person or Company Who Maintains the Pump 54 =    Additional Lift 255 = \*    Rated Pump Capacity 268 = \*

**STANDBY POWER DATA (2)**

(See LIFT DATA for codes of fields 43 and 56 below)

R = 55 \*    T = A D M \*    Type of Lift 43 # \*    Type of Power 56 = \*    Horsepower 57 = \*    Lift Entry No 254 # \*  
add, delete, modify

**AVAILABLE LOG DATA (1)**

R = 188 \*    T = A D M \*    New Card for Each Log Type Same R & T

Type of Log 199 # *	Begin Depth 200 = *	End Depth 201 = *	Source of Data 202 = *
199 # *	200 = *	201 = *	202 = *
199 # *	200 = *	201 = *	202 = *
199 # *	200 = *	201 = *	202 = *

**WATER QUALITY DATA COLLECTION (1)**

R = 114 \*    T = A D M \*    Begin Year 115 #    End Year 116 = \*    Source Agency 117 = \*  
add, delete, modify

Frequency of Collection 118 = \*    Network Site 257 = \*    Type of Analyses 120 = \*

**WATER LEVEL DATA COLLECTION (1)**

R = 121 \*    T = A D M \*    Begin Year 122 # 1987 \*    End Year 123 = \*    Source Agency 124 = GROSA \*  
add, delete, modify

Frequency of Collection 125 = \*    Network Site 258 = \*

**WATER PUMPAGE/WITHDRAWAL DATA COLLECTION (1)**

R = 127 \*    T = A D M \*    Begin Year 128 #    End Year 129 = \*    Source Agency 130 = \*  
add, delete, modify

Frequency of Collection 131 = \*    Network Site 259 = \*    Method of Collection 133 = C E M U Z \*  
calculated, estimated, metered, unknown, other

**OTHER DATA AVAILABLE (1)**

R = 180 \*    T = A D M \*    Type of Data 181 #    Loc 182 = C D Z \*    Format 261 = F M P Z \*  
add, delete, modify    cooperster, district, other    files, machine, published, other readable

New Card Same R & T    Type of Data 181 #    Loc 182 = C D Z \*    Format 261 = F M P Z \*

**FOOT NOTES:**

① Source of Data Codes:

S D Ø A R L G Z  
reporting, driller, owner, other gov't, other logs, geologist, other agency

③ Frequency of Collection Codes

A B C D F I M Ø Q S W Z  
annual, bi-monthly, continuous, daily, semi, intermittent, monthly, one time, quarter, semi-, weekly, other monthly    only annual annual

② Type of Log Codes

A B C D E F G H I J K L M N Ø P Q  
time, collar, caliper, driller's, electric, fluid, geologist, magnetic, induction, gamma, dipmeter, laterlog, microlog, neutron, µ later, photo, radio-, conduct    ray    active

S T U V Z  
sonic, temp, gamma, fluid, other gamma velocity

④ Type of Quality Analyses Codes

A B C D E F G H J K L M Z  
physical, common, trace, pesticides, nutrients, sanitary, codes, codes, codes, codes, codes, other, other chemical elements    B&D B&E B&F D&E C,D&E most

# KLAM 12221

**GEOHYDROLOGIC UNIT DESCRIPTIONS (1)**

\*  \* Entry No.  #  \* Depth to Top  -  \* Depth to Bottom  -  \*

Unit Identifier  -  \* Lithology  -  \* Lithologic Modifier  -  \*

**AQUIFER DATA (2)**

\*  \* Geohydrologic Unit Entry No.  #  \*

Date  # / / \* Water Level  -  \* % Water Contributed  -  \*

**GEOHYDROLOGIC UNIT DESCRIPTIONS (1)**

\*  \* Entry No.  #  \* Depth to Top  -  \* Depth to Bottom  -  \*

Unit Identifier  -  \* Lithology  -  \* Lithologic Modifier  -  \*

**AQUIFER DATA (2)**

\*  \* Geohydrologic Unit Entry No.  #  \*

Date  # / / \* Water Level  -  \* % Water Contributed  -  \*


**PERTINENT REMARKS**

\*  \*  -  \*  
 add  
 -  \*  
  -  \*

**NOTES:**

MP. Hole in pump base (by copper tube), 1.0ft. above LSD. (C)


# KLAM 12221

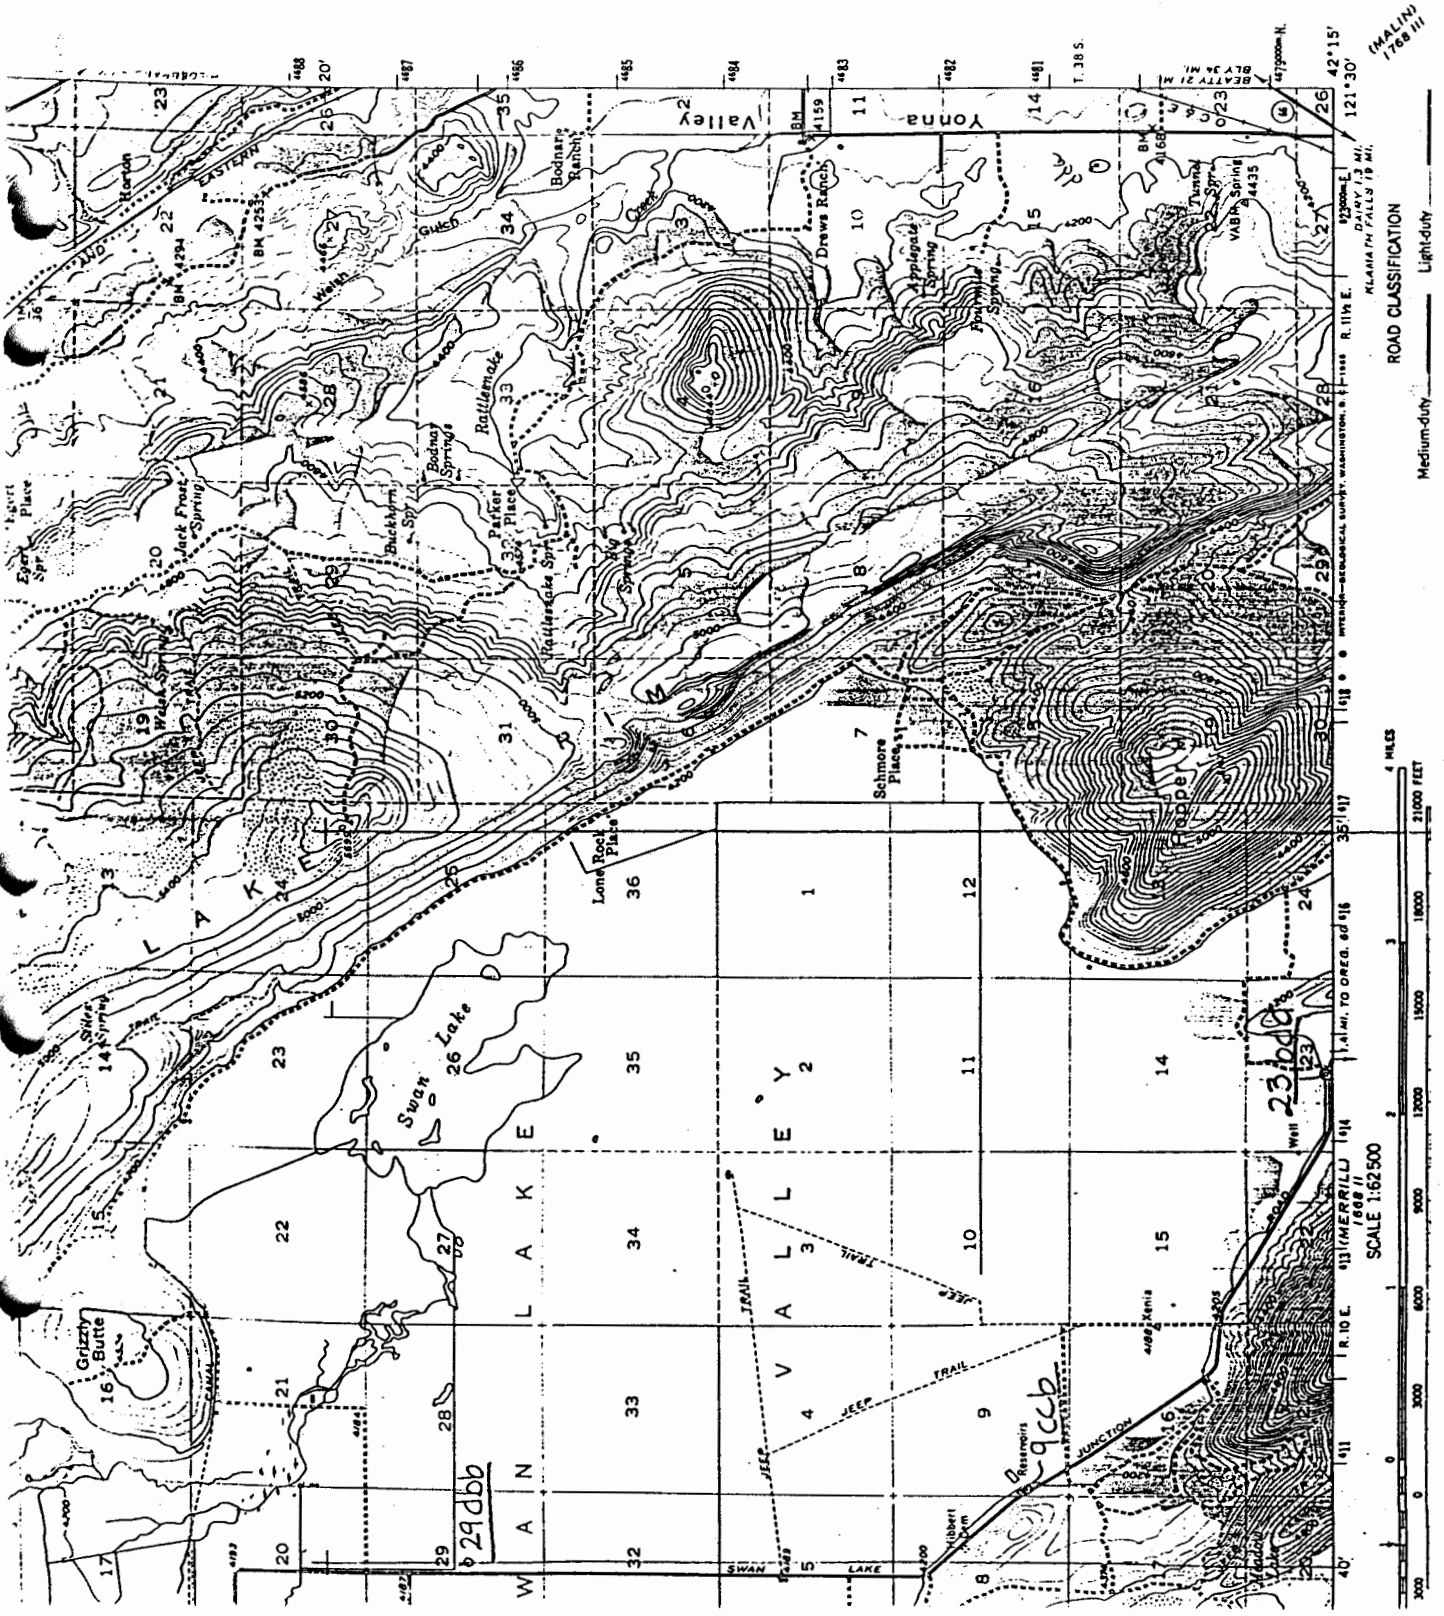


ROAD CLASSIFICATION  
Medium-duty Light-duty

SCALE 1:62,500  
4 MILES  
31,000 FEET

KLAMATH NATIONAL FOREST  
SWAN LAKE

T.38S. R.10E W.M.

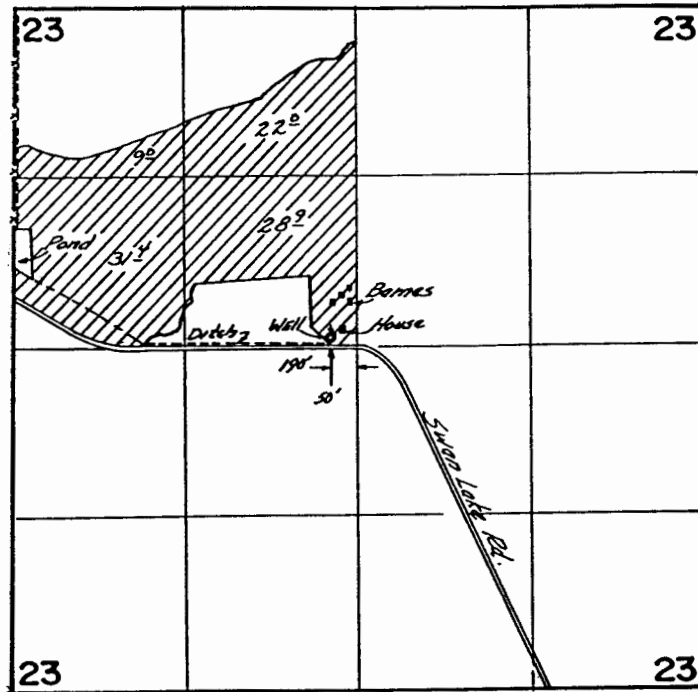

**FINAL PROOF SURVEY**  
UNDER

Application No. G-6024 Permit No. G-5146...  
IN NAME OF

Lloyd Ray & Carol D. Golbek

Surveyed Sept..20. 1979., by C.R.RODRIGUEZ



9-185.  
(October 1950)

UNITED STATES  
DEPARTMENT OF THE INTERIOR  
GEOLOGICAL SURVEY  
WATER RESOURCES DIVISION

WELL SCHEDULE

Date June 16, 19 59 Field No. 38/10 - 23F1  
Record by Rdr Office No. \_\_\_\_\_  
Source of data Obs.

1. Location: State Oregon County Klamath  
Map \_\_\_\_\_

\_\_\_\_\_  $\frac{1}{4}$  \_\_\_\_\_  $\frac{1}{4}$  sec. \_\_\_\_\_ T \_\_\_\_\_ N \_\_\_\_\_ S \_\_\_\_\_ R \_\_\_\_\_ E \_\_\_\_\_ W

2. Owner: \_\_\_\_\_ Address \_\_\_\_\_  
Tenant \_\_\_\_\_ Address \_\_\_\_\_  
Driller \_\_\_\_\_ Address \_\_\_\_\_

3. Topography plain

4. Elevation 4200 ft. above scu (map) below

5. Type: Dug, drilled, driven, bored, jetted \_\_\_\_\_ 19 57-8

6. Depth: Rept. \_\_\_\_\_ ft. Meas. \_\_\_\_\_ ft.

7. Casing: Diam. \_\_\_\_\_ in., to \_\_\_\_\_ in., Type \_\_\_\_\_  
Depth \_\_\_\_\_ ft., Finish \_\_\_\_\_


8. Chief Aquifer \_\_\_\_\_ From \_\_\_\_\_ ft. to \_\_\_\_\_ ft.  
Others \_\_\_\_\_

9. Water level \_\_\_\_\_ ft. rept. \_\_\_\_\_ 19 \_\_\_\_\_ above \_\_\_\_\_ below \_\_\_\_\_  
which is \_\_\_\_\_ ft. above \_\_\_\_\_ below surface

10. Pump: Type \_\_\_\_\_ Capacity \_\_\_\_\_ G. M. \_\_\_\_\_  
Power: Kind \_\_\_\_\_ Horsepower \_\_\_\_\_

11. Yield: Flow \_\_\_\_\_ G. M., Pump 2,500 G. M., Meas., Rept. Est.  
Drawdown \_\_\_\_\_ ft. after \_\_\_\_\_ hours pumping \_\_\_\_\_ G. M.

12. Use: Dom., Stock, PS., RR., Ind., Irr., Obs. \_\_\_\_\_  
Adequacy, permanence \_\_\_\_\_

13. Quality \_\_\_\_\_ Temp 66 1/2 °F.  
Taste, odor, color \_\_\_\_\_ Sample Yes \_\_\_\_\_  
Unfit for \_\_\_\_\_

14. Remarks: (Log, Analyses, etc.) \_\_\_\_\_  
\_\_\_\_\_  
\_\_\_\_\_