

STATE ENGINEER
Salem, Oregon

KLAM
12228

Well Record

STATE WELL NO. 38/10-26C(1)
COUNTY Klamath
APPLICATION NO. U-323

OWNER: Maude E. Liskey


MAILING ADDRESS: 1041 El Dorado Avenue

LOCATION OF WELL: Owner's No.

CITY AND STATE: Klamath Falls, Oregon

NE 1/4 NW 1/4 Sec. 26 T. 38 N. S., R. 10 W., W.M.

Bearing and distance from section or subdivision corner

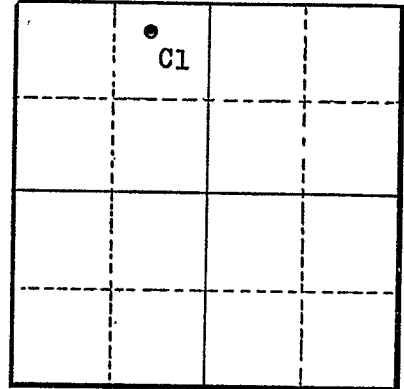

Section 26

Altitude at well 4221

TYPE OF WELL: Drilled Date Constructed

Depth drilled 582 Depth cased 15'

CASING RECORD:

16 inches 15 feet

FINISH:

AQUIFERS:

Porous lava rock from 560 to 581

WATER LEVEL:

126.55 feet below land surface, July 19, 1949

PUMPING EQUIPMENT: Type H.P.
Capacity G.P.M.

WELL TESTS:

Drawdown ft. after hours G.P.M.
Drawdown ft. after hours G.P.M.

USE OF WATER Irrigation Temp. °F., 19

SOURCE OF INFORMATION USGS

DRILLER or DIGGER

ADDITIONAL DATA:

Log Water Level Measurements Chemical Analysis Aquifer Test

REMARKS:

Test pumped 700 and 2,165 gpm when bottom at 282 and 560' depth, respectively; drawdown was 2.5' at the latter rate.

STATE ENGINEER
Salem, Oregon

State Well No. 38/10-260(1)
County Klamath
Application No. _____

Well Log

Owner: Dave Liskey Owner's No. _____

Driller: K. Hartley Date Drilled 1949

CHARACTER OF MATERIAL	(Feet below land surface)		Thickness (feet)
	From	To	
Alluvium, undifferentiated:			
Soil	0	2	2
Clay, yellow	2	5	3
Sandstone, brown	5	10	5
Clay, yellow	10	19	9
Shale, blue	19	30	11
Clay, yellow	30	65	35
Sandstone, yellow	65	100	35
Sandstone, yellow, and clay red hard	100	150	50
Upper Lava Rocks:			
Lava rock, porous, black	150	175	25
Clay, red, and sandstone	175	198	23
Lava rock, porous, black, water bearing	198	397	199
Cinders, red	397	401	4
Lava rock, porous, black, water bearing	401	428	27
Basalt, hard and blue	428	442	14
Lava rock, porous, black, water bearing	442	487	45
Basalt, hard	487	503	16
Lava rock, and cinders, red	503	511	8
Lava rock, porous, black, water bearing	511	524	13
Basalt, hard	524	537	13
Lava rock and cinders, red	537	559	22
Sand, coarse, black	559	560	1
Lava rock, porous, black, water bearing	560	581	21
Basalt, hard, blue	581	582	1

STATE ENGINEER
Salem, Oregon

State Well No. 38/10-26C(1)

County Klamath

Application No. 0323

Water Level Record

OWNER: _____ OWNER'S NO. _____

Description of measuring point: _____

Date	Water Level Feet (above) (below) Land Surface	Remarks	Date	Water Level Feet (above) (below) Land Surface	Remarks
June 56	125.9	Annual well report			
Nov 56	126.9	do			

REMARKS: _____
