

STATE ENGINEER *KLAM 12261*
Salem, Oregon

Well Record

STATE WELL NO. *38/11-5P(1)*
COUNTY *Klamath*
APPLICATION NO. *0269 0407*

OWNER: *Leonard Ritter*


MAILING ADDRESS: *G-927*
G-4781

LOCATION OF WELL: Owner's No. _____

CITY AND STATE: _____

SE 1/4 *SW* 1/4 Sec. *5* T. *38* S., R. *11* W., W.M.

Bearing and distance from section or subdivision corner _____

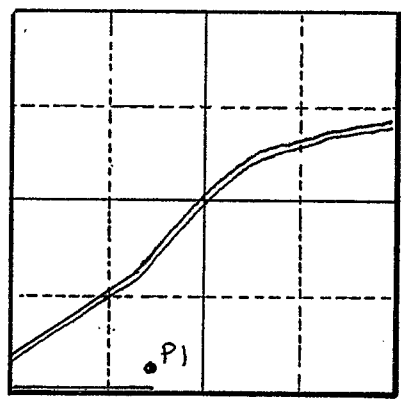

Section *5*

Altitude at well *4,252*

TYPE OF WELL: *Drilled* Date Constructed *1948*

Depth drilled *200* Depth cased *12ft.*

CASING RECORD:
16 inches, 12 ft.

FINISH:

AQUIFERS: *Broken lava rock from 181 to 200 ft.*

WATER LEVEL: *129.38 feet below land surface, April 2, 1948*

PUMPING EQUIPMENT: Type *Turbine* *Johnston* H.P. *60*
Capacity *1,600* G.P.M.

WELL TESTS:
Drawdown *2* ft. after _____ hours *1600* G.P.M.
Drawdown _____ ft. after _____ hours _____ G.P.M.

USE OF WATER *Irrigation* Temp. _____ °F. _____, 19____

SOURCE OF INFORMATION *USGS*

DRILLER or DIGGER _____

ADDITIONAL DATA:
Log Water Level Measurements _____ Chemical Analysis _____ Aquifer Test _____

REMARKS: *Well yeilds 1,600 gpm with drawdown of 2 ft after 5 minutes;*

