

STATE ENGINEER
Salem, Oregon

KLAM 12268

Well Record

STATE WELL NO. 38/11-6N(1)
COUNTY Klamath
APPLICATION NO. 4245

OWNER: J.P. Colahan
MAILING ADDRESS:

LOCATION OF WELL: Owner's No. CITY AND STATE:

SW 1/4 SW 1/4 Sec. 6 T. 38 S. R. 11 E. W., W.M.


Bearing and distance from section or subdivision corner

Altitude at well 4,198

TYPE OF WELL: Drilled Date Constructed

Depth drilled 325 Depth cased 18 ft.

CASING RECORD: 16 inches, 18 ft.

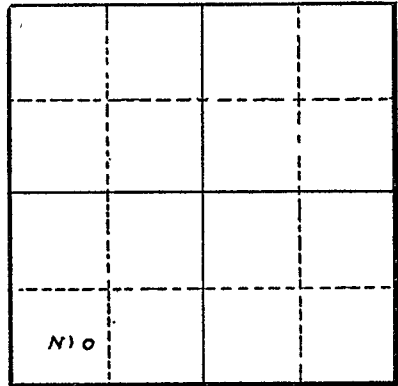

Section 6

FINISH:

AQUIFERS: Cinders from 315 ft. to 325

WATER LEVEL: 82 feet below land surface, May 1949.

PUMPING EQUIPMENT: Type Turbine H.P.
Capacity 1,000 G.P.M.

WELL TESTS:
Drawdown ft. after hours G.P.M.
Drawdown 15 ft. after 2 hours 1000 G.P.M.

USE OF WATER Irrigation 3200 Temp. °F., 19

SOURCE OF INFORMATION USGS

DRILLER or DIGGER

ADDITIONAL DATA:
Log X Water Level Measurements Chemical Analysis Aquifer Test

REMARKS: Test pumped at 1,000 gpm with drawdown of 15 ft. after 2 hours.

