

OBSERVATION WELL

STATE ENGINEER
Salem, Oregon

KLAM 12269

Well Record


STATE WELL NO. 38/11-6R(1)
COUNTY Klamath
APPLICATION NO. U-465

OWNER: John Hartzler (P.J. JENDRZEJEWSKI) MAILING ADDRESS: _____

LOCATION OF WELL: Owner's No. _____ CITY AND STATE: Dairy, Oregon

SE 1/4 SE 1/4 Sec. 6 T. 38 S. R. 11 M. E. W., W.M.

Bearing and distance from section or subdivision corner N 64° 18' E 2930' from S 1/4 cor. Sec. 6

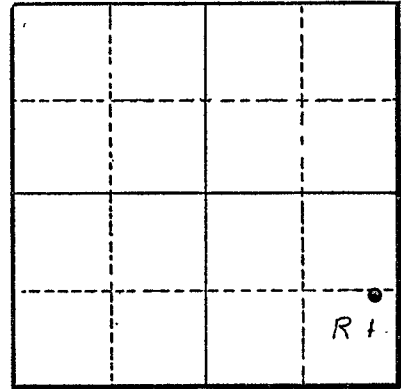

Section 6

Altitude at well _____

TYPE OF WELL: Drilled Date Constructed Spring 1954

Depth drilled 194 Depth cased _____

CASING RECORD:

16 inch

FINISH:

AQUIFERS:

WATER LEVEL:

106 April 1954

PUMPING EQUIPMENT: Type _____ H.P. _____
Capacity _____ G.P.M.

WELL TESTS:

Drawdown 4 ft. after _____ hours pumping 3200 G.P.M.

Drawdown _____ ft. after _____ hours _____ G.P.M.

USE OF WATER Irrigation Temp. _____ °F., 19

SOURCE OF INFORMATION U-465

DRILLER or DIGGER W. L. Hartley & Son

ADDITIONAL DATA:

Log Water Level Measurements _____ Chemical Analysis _____ Aquifer Test _____

REMARKS:

Water Level Record

OWNER: Hartzler OWNER'S NO. _____

Description of measuring point: Top of casing, 1 foot above L.S.P.

Date	Water Level Feet (above) (below) Land Surface	Remarks	Date	Water Level Feet (above) (below) Land Surface	Remarks
4-24-57	104.70	JES			
10-17-57	105.08	JES			
6-4-58	103.85	JES			
10-30-58	104.20	JES			
9-27-61	—	WSB wet Tapes			

REMARKS: _____

