

STATE ENGINEER
Salem, Oregon

KLAM
12286

Well Record

STATE WELL NO. 38/11-7M(1)
COUNTY Klamath
APPLICATION NO. U-286

OWNER: Louis Tofel


MAILING ADDRESS:

LOCATION OF WELL: Owner's No. 1

CITY AND STATE: Bonanza

N. E.
NW 1/4 SW 1/4 Sec. 7 T. 38 S., R. 11 W., W.M.

Bearing and distance from section or subdivision corner

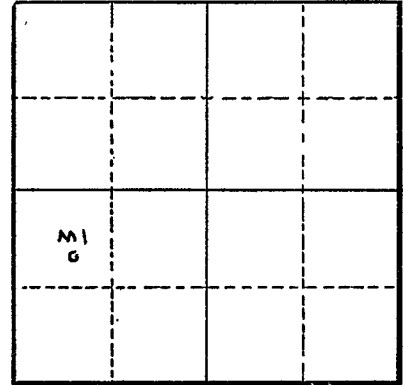

Altitude at well 4,205

TYPE OF WELL: Drilled Date Constructed

Depth drilled 260 Depth cased ~~275~~

Section 7

CASING RECORD: 12 inches.

FINISH:

AQUIFERS: Red and gray cinders from 242 fto to 260 ft.

WATER LEVEL: 88.64 feet below land surface, July 20, 1949

PUMPING EQUIPMENT: Type Turbine H.P.
Capacity 1,200 G.P.M.

WELL TESTS:
Drawdown ft. after hours G.P.M.
Drawdown ft. after hours G.P.M.

USE OF WATER Irrigation Temp. °F., 19

SOURCE OF INFORMATION USGS U-286

DRILLER or DIGGER

ADDITIONAL DATA:
Log Water Level Measurements Chemical Analysis Aquifer Test

REMARKS: Yields 1,000 gpm.

