

STATE ENGINEER
Salem, Oregon

KLAM
12345

Well Record

STATE WELL NO. 38/11-18D(1)
COUNTY Klamath
APPLICATION NO.

OWNER: ~~C.W. Fyock~~ Ernie Ritter


MAILING ADDRESS:

LOCATION OF WELL: Owner's No.

CITY AND STATE:

NW NW 18 38 N. 11 E.
1/4 1/4 Sec. T. S., R. W., W.M.

Bearing and distance from section or subdivision corner

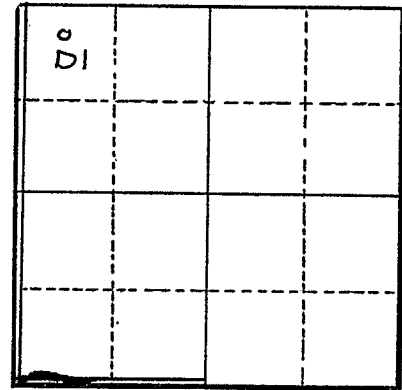

Section 18

Altitude at well 4.182

TYPE OF WELL: Drilled Date Constructed

Depth drilled Depth cased 100 ft.

CASING RECORD: 12 inches, 100 ft.

FINISH:

AQUIFERS:

WATER LEVEL: 66.24 feet below land surface, July 20, 1949

PUMPING EQUIPMENT: Type Turbine H.P.
Capacity G.P.M.

WELL TESTS:
Drawdown ft. after hours G.P.M.
Drawdown ft. after hours G.P.M.

USE OF WATER Irrigation Temp. °F., 19

SOURCE OF INFORMATION USGS

DRILLER or DIGGER

ADDITIONAL DATA:
Log Water Level Measurements Chemical Analysis Aquifer Test

REMARKS: Hardness 48 ppm, chloride 2ppm. Yields 2,000 gpm.