

STATE ENGINEER
Salem, Oregon

KLAM
12364

Well Record

STATE WELL NO. 38/11-31^A(1)
COUNTY Klamath
APPLICATION NO. _____

OWNER: Haskins and Company


MAILING ADDRESS: Rt 1, Bonanza, Oregon

LOCATION OF WELL: Owner's No. 2

CITY AND STATE: _____

NW 1/4 NE 1/4 Sec. 31 T. 38 S., R. 11 E. W., W.M.

Bearing and distance from section or subdivision corner _____

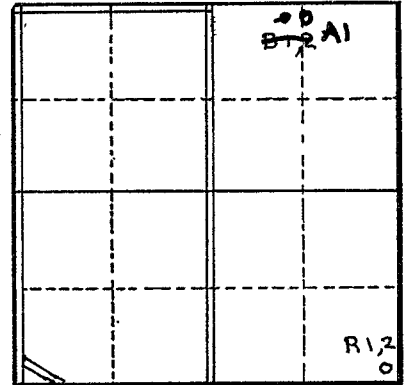

Altitude at well 4,183

Section 31

TYPE OF WELL: Drilled Date Constructed _____

Depth drilled 178 285 Depth cased 20 ft.

CASING RECORD: 16 inches, 20 ft.

FINISH: _____

AQUIFERS: ? Broken lava rock 55 ft. to 175 ft.

WATER LEVEL: 68.68 feet below land surface, November 16, 1949

PUMPING EQUIPMENT: Type Turbine H.P. _____
Capacity _____ G.P.M.

WELL TESTS:
Drawdown _____ ft. after _____ hours _____ G.P.M.
Drawdown _____ ft. after _____ hours _____ G.P.M.

USE OF WATER Stock & Irrigation Temp. _____ °F., 19____

SOURCE OF INFORMATION USGS

DRILLER or DIGGER _____

ADDITIONAL DATA:
Log _____ Water Level Measurements _____ Chemical Analysis _____ Aquifer Test _____

REMARKS: Hardness 50ppm, chloride 3ppm. Yields 1,200 gpm with drawdown of 2.8 ft; driller reports "sandstone" over aquifer.

STATE ENGINEER
Salem, Oregon

38/11-31A(1)

State Well No. ~~211-23~~
County ~~WASCO~~ KLAMATH
Application No. U 451

Water Level Record

OWNER: J. LUTHER HASKINS & FAMILY ETC. OWNER'S NO. ~~1~~ 2

Description of measuring point: Hole in Concrete Pump base on North Side of well, 1.00 ft. above LSD

Date	Water Level Feet (above) (below) Land Surface	Remarks	Date	Water Level Feet (above) (below) Land Surface	Remarks
4-29-58	66	Final Proof Survey			

REMARKS: _____

