

STATE ENGINEER
Salem, Oregon

KLAM
12380

Well Record

STATE WELL NO. 38/11 1/2-2Q(1)
COUNTY Klamath
APPLICATION NO. U-464

OWNER: Jesse J. Angel Jr. MAILING ADDRESS: _____

LOCATION OF WELL: Owner's No. 1 CITY AND STATE: Dairy, Oregon


SW 1/4 SE 1/4 Sec. 2 T. 38 S., R. 11 1/2 W., W.M.

Bearing and distance from section or subdivision corner N 64° 24' E. 1394' from S 1/4 cor. Sec. 2

Altitude at well _____

TYPE OF WELL: _____ Date Constructed March 1954

Depth drilled 583 Depth cased 31

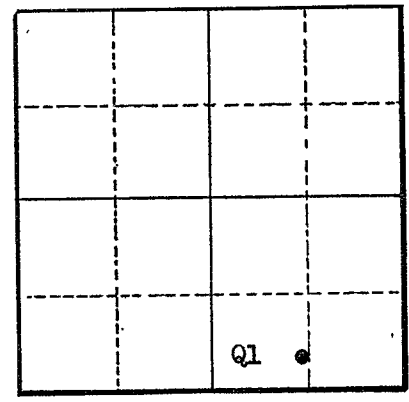

Section 2

CASING RECORD:

18 inch

FINISH:

AQUIFERS:

Lava and cinders from 556 to 583'

WATER LEVEL:

70' when completed 3/24/54 71.57 7/27/54 USGS

PUMPING EQUIPMENT: Type Turbine H.P. 40
Capacity 1700 G.P.M. at 78' of head

WELL TESTS:

Drawdown to 78' ft. after _____ hours at 1700 G.P.M.
Drawdown to 82 ft. after _____ hours 2000 G.P.M.

USE OF WATER Irrigation Temp. _____ °F. _____, 19____

SOURCE OF INFORMATION U.S.G.S. U-464

DRILLER or DIGGER W.L. Hartley & Son

ADDITIONAL DATA:

Log Water Level Measurements _____ Chemical Analysis _____ Aquifer Test _____

REMARKS:

Drawdown to 88' at 2500 gpm
Drawdown to 93' at 3200 gpm

