

STATE ENGINEER  
Salem, Oregon

KLAM  
12382

# Well Record

STATE WELL NO. 38/11½-3K(1)  
COUNTY Klamath  
APPLICATION NO. U-306

OWNER: J. N. Drew


MAILING  
ADDRESS:

LOCATION OF WELL: Owner's No.

CITY AND  
STATE:

NE ¼ SE ¼ Sec. 3 T. 38 N. S. R. 11½ E. W.M.

Bearing and distance from section or subdivision  
corner N 47° 9½' W. 36.65 chs. from SE cor.  
Sec. 3

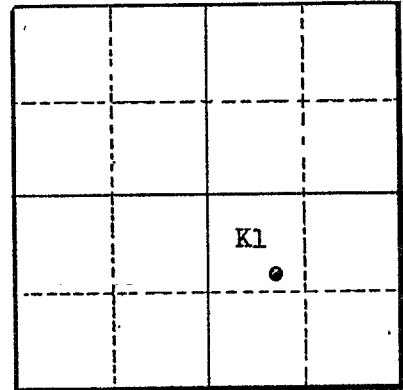

Section 3

Altitude at well 4190

TYPE OF WELL: Drilled Date Constructed Spring 1949

Depth drilled 194 Depth cased 20'

### CASING RECORD:

16 inches, 20 feet

### FINISH:

### AQUIFERS:

Broken porous lava from 110 to 194'

### WATER LEVEL:

70.91' below land surface July 19, 1949

PUMPING EQUIPMENT: Type Turbine H.P.

Capacity 1750 G.P.M.

### WELL TESTS:

Drawdown ft. after hours G.P.M.

Drawdown ft. after hours G.P.M.

USE OF WATER Irrigation Temp. °F., 19

SOURCE OF INFORMATION USGS Well 3J1 in USGS Report

DRILLER or DIGGER

### ADDITIONAL DATA:

Log Water Level Measurements Chemical Analysis Aquifer Test

### REMARKS:

Yield 2500 gpm; driller reports mostly "chalk" overlies aquifer.

