

STATE ENGINEER
Salem, Oregon

KLAM
12391

Well Record

STATE WELL NO. 38/11 $\frac{1}{2}$ -12B(1)
COUNTY Klamath
APPLICATION NO. 628

OWNER: Joe Vierra

MAILING
ADDRESS:

LOCATION OF WELL: Owner's No.

CITY AND
STATE:

NW NE 12 T. 38 N. 11 $\frac{1}{2}$ E.
1/4 1/4 Sec. S. R. W., W.M.

Bearing and distance from section or subdivision


corner 447' S & W from
NE corner NW 1/4, NE 1/4, Sec 12

Altitude at well 4,180

TYPE OF WELL: Drilled Date Constructed

Depth drilled 280 Depth cased 8 ft.

CASING RECORD: 16 inches, 8 ft.

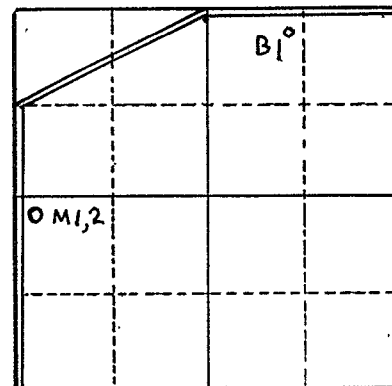

Section 12

FINISH:

AQUIFERS: Broken lava rock from 272 ft. to 280

WATER LEVEL: 64.84 feet below land surface, April 3, 1948

PUMPING EQUIPMENT: Type Turbine H.P. 25
Capacity 1,100 G.P.M.

WELL TESTS:
Drawdown 6" ft. after 3 hours pumping 1500 G.P.M.
Drawdown ft. after hours G.P.M.

USE OF WATER Irrigation Temp. °F., 19

SOURCE OF INFORMATION USGS U. 245

DRILLER or DIGGER

ADDITIONAL DATA:

Log ☒ Water Level Measurements Chemical Analysis Aquifer Test

REMARKS: Drawdown 6 in. after 3 hours pumping at 1,500 gpm.

State Well No. 38/111-12B(1)
County Klamath
Application No. U-265

Owner: Joe Vieira Owner's No. 1
Driller: F. Hilton & K. Hartley Date Drilled 1948

[illegible]