

STATE ENGINEER  
Salem, Oregon

KLAM  
12395

# Well Record

STATE WELL NO. 38/11 1/2-12P(1)  
COUNTY Klamath  
APPLICATION NO. U-446

OWNER: F. M. Challis


MAILING ADDRESS: Route 1, Box 145

LOCATION OF WELL: Owner's No. 2

CITY AND STATE: Bonanza, Oregon

SE 1/4 SW 1/4 Sec. 12 T. 38 N. S. R. 11 1/2 W. W.M.

Bearing and distance from section or subdivision  
corner N 82° 30' E 2232' from SW cor. Sec. 12

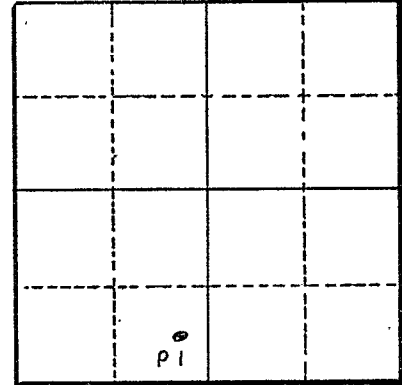

Section 12

Altitude at well

TYPE OF WELL: Drilled Date Constructed

Depth drilled 170 Depth cased

### CASING RECORD:

### FINISH:

### AQUIFERS:

### WATER LEVEL:

PUMPING EQUIPMENT: Type Turbine H.P. 40  
Capacity 2400 G.P.M.

### WELL TESTS:

Drawdown ft. after hours G.P.M.  
Drawdown ft. after hours G.P.M.

USE OF WATER Irrigation Temp. °F., 19

SOURCE OF INFORMATION U-401

DRILLER or DIGGER

### ADDITIONAL DATA:

Log Water Level Measurements Chemical Analysis Aquifer Test

### REMARKS: