

STATE ENGINEER  
Salem, Oregon

12LAM  
12398

# Well Record

STATE WELL NO. 38/11-13(1)  
COUNTY Klamath  
APPLICATION NO. 4258

OWNER: William Konig


MAILING ADDRESS:

LOCATION OF WELL: Owner's No.

CITY AND STATE: Bonanza Oregon

SE 1/4 SW 1/4 Sec. 13 T. 38 N. S. R. 11 1/2 W. W.M.

Bearing and distance from section or subdivision corner  
N 66° 29' E - 2261' from SW corner section 13

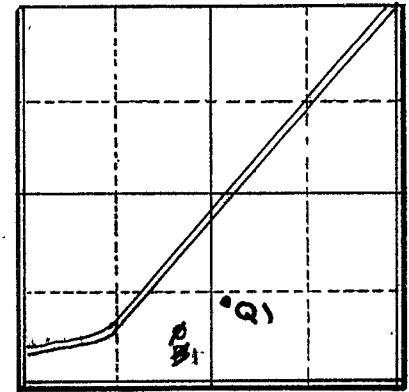

Section 13

Altitude at well 4,151

TYPE OF WELL: Drilled Date Constructed  
Depth drilled 475 Depth cased 16 ft.

CASING RECORD: 16 inches, 16 ft.

FINISH:

AQUIFERS: Broken lava rock and cinders from 468 to 484 ft.

WATER LEVEL: 36.67 feet below land surface, April 2, 1948

PUMPING EQUIPMENT: Type Turbine H.P. 30  
Capacity 1,600 G.P.M.

WELL TESTS:  
Drawdown ft. after hours G.P.M.  
Drawdown ft. after hours G.P.M.

USE OF WATER Irrigation Temp. °F., 19

SOURCE OF INFORMATION USGS

DRILLER or DIGGER

ADDITIONAL DATA:  
Log  Water Level Measurements Chemical Analysis Aquifer Test

REMARKS: Hardness 60ppm, chloride 11ppm. Reported to draw down 5 ft. while pumping.

