

STATE ENGINEER  
Salem, Oregon

KLAM  
12411

# Well Record

STATE WELL NO. 38/11 $\frac{1}{2}$ -23F(1)  
COUNTY Klamath  
APPLICATION NO. U-264

OWNER: Cliff Sewald


MAILING ADDRESS:

LOCATION OF WELL: Owner's No.

CITY AND STATE:

SE  $\frac{1}{4}$  NW  $\frac{1}{4}$  Sec. 23 T. 38 N. S. R. 11 $\frac{1}{2}$  W. W.M.

Bearing and distance from section or subdivision corner

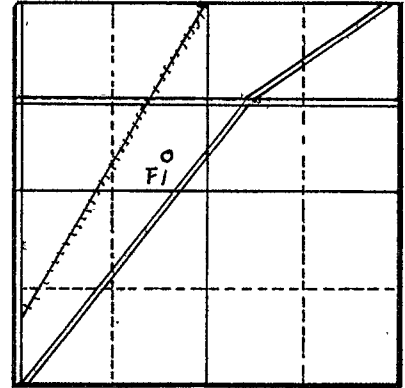

Section 23

Altitude at well 4,170

TYPE OF WELL: Drilled Date Constructed

Depth drilled 286 Depth cased 14 ft.

CASING RECORD: 12 inches, 14 ft.

FINISH:

AQUIFERS: Porous lava rock zone from 225 ft. to 286 ft.

WATER LEVEL: 51 $\frac{1}{2}$  feet below land surface, August 1948

PUMPING EQUIPMENT: Type Turbine H.P.  
Capacity 1,600 G.P.M.

WELL TESTS:  
Drawdown ft. after hours G.P.M.  
Drawdown ft. after hours G.P.M.

USE OF WATER Irrigation Temp. °F., 19

SOURCE OF INFORMATION USGS

DRILLER or DIGGER

ADDITIONAL DATA:  
Log  Water Level Measurements  Chemical Analysis  Aquifer Test

REMARKS: Hardness 55ppm, chloride 3ppm. Yields 1,600 gpm; drawdown is 17 ft. after 1 minute pumping; water sample for field analysis taken 7/19/49.

