

STATE ENGINEER  
Salem, Oregon

KLAM  
12415

# Well Record

STATE WELL NO. 38/11 $\frac{1}{2}$ -24P(1)  
COUNTY Klamath  
APPLICATION NO. (534)

OWNER: Haskins & Company

MAILING ADDRESS:


LOCATION OF WELL: Owner's No. 1

CITY AND STATE:

Behanza Oregon

SE  $\frac{1}{4}$  SW  $\frac{1}{4}$  Sec. 24 T. 38 N. 11 $\frac{1}{2}$  E. S., R. W., W.M.

Bearing and distance from section or subdivision corner  
N 62° 55' W - 1437' from S $\frac{1}{2}$  corner Section 24

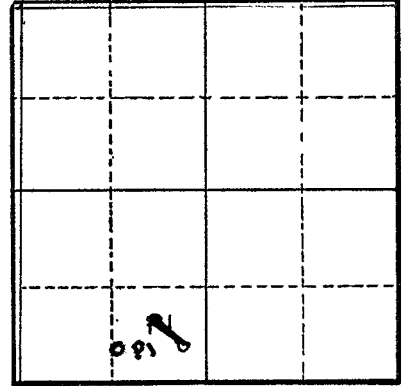

Altitude at well 4,150

Section 24

TYPE OF WELL: Drilled Date Constructed 1949

Depth drilled 984 Depth cased 40 ft.

CASING RECORD: 18 inches, 40 ft.

FINISH:

AQUIFERS: Broken burnt lava rock from 984 ft. to 995 ft.

WATER LEVEL: 37.67 feet below land surface, July 19, 1949

PUMPING EQUIPMENT: Type Turbine H.P. 60  
Capacity G.P.M.

WELL TESTS:  
Drawdown 42 ft. after 2100 hours 9pm G.P.M.  
Drawdown ft. after hours G.P.M.

USE OF WATER Irrigation Temp. °F., 19

SOURCE OF INFORMATION USGS

DRILLER or DIGGER

ADDITIONAL DATA:

Log  Water Level Measurements  Chemical Analysis  Aquifer Test

REMARKS: Test pumped 2,100 gpm with 42 ft. of drawdown. Hardness 75ppm chloride 7ppm

