

STATE ENGINEER
Salem, Oregon


KLAM
12418

Well Record

STATE WELL NO. 38/11 $\frac{1}{2}$ -26H(1)
COUNTY Klamath
APPLICATION NO. 0289

OWNER: Cliff Seward MAILING ADDRESS: _____
CITY AND STATE: _____
LOCATION OF WELL: Owner's No. _____

SE $\frac{1}{4}$ NE $\frac{1}{4}$ Sec. 26 T. 38 ^{N.} S., R. 11 $\frac{1}{2}$ ^{E.} W.M.
Bearing and distance from section or subdivision
corner N 32° 07' W - 1220' from
W. East $\frac{1}{4}$ Corner Section
26

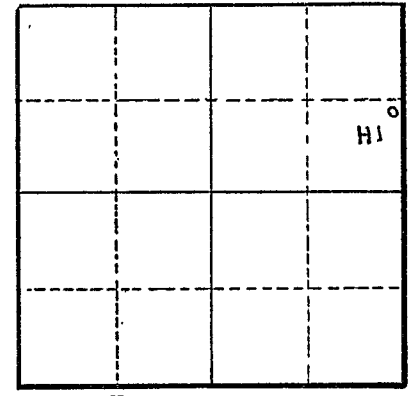

Section 26

Altitude at well 4,162
Drilled
TYPE OF WELL: _____ Date Constructed _____
Depth drilled 191 Depth cased 20 ft.

CASING RECORD: 20 inches, 20 ft.

FINISH:

AQUIFERS: Broken lava from 183 ft. to 191 ft.

WATER LEVEL: 47.02 feet below land surface, July 18, 1949

PUMPING EQUIPMENT: Type Turbine Johnston H.P. 75
Capacity _____ G.P.M.

WELL TESTS:
Drawdown 7 ft. after _____ hours 3000 G.P.M.
Drawdown _____ ft. after _____ hours _____ G.P.M.

USE OF WATER Irrigation Temp. _____ °F. _____, 19____

SOURCE OF INFORMATION USGS

DRILLER or DIGGER _____

ADDITIONAL DATA:
Log Water Level Measurements _____ Chemical Analysis _____ Aquifer Test _____

REMARKS: Hardness 50ppm, chloride 4ppm. Yields 3,00 gpm with 7 ft. of drawdown.

