

STATE ENGINEER  
Salem, Oregon


KLAM  
123419

# Well Record

STATE WELL NO. 38/11 $\frac{1}{2}$ -2742 <sup>28 M (1)</sup>  
COUNTY Klamath  
APPLICATION NO. U300

OWNER: Guy Barton  
MAILING ADDRESS: Rt 2, Box 838  
CITY AND STATE: Klamath Falls

LOCATION OF WELL: Owner's No. 1  
NE  $\frac{1}{4}$  SE  $\frac{1}{4}$  Sec. 29 T. 38 N. S., R. 11 $\frac{1}{2}$  W., W.M.  
Bearing and distance from section or subdivision  
corner N4° 01' E - 1820' from  
SE corner Section 29

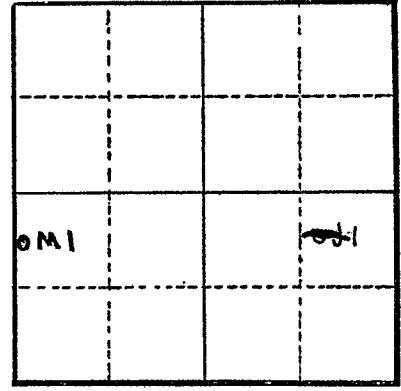

Altitude at well 4,200

TYPE OF WELL Drilled Date Constructed 1948  
Depth drilled 136 Depth cased 60 ft.

Section 29

CASING RECORD: 16 inches, 60 ft.

FINISH:

AQUIFERS: Porous lava from 100 ft. to 136 ft.

WATER LEVEL: 94 feet below land surface, September 1949

PUMPING EQUIPMENT: Type Turbine H.P. 50  
Capacity 1400 G.P.M.

WELL TESTS:  
Drawdown ..... ft. after ..... hours ..... G.P.M.  
Drawdown ..... ft. after ..... hours ..... G.P.M.

USE OF WATER Irrigation Temp. °F. ...., 19

SOURCE OF INFORMATION USGS U300

DRILLER or DIGGER  
ADDITIONAL DATA:

Log  Water Level Measurements ..... Chemical Analysis ..... Aquifer Test .....

REMARKS: Hardness 75ppm, chloride 10ppm. Test pumped 1,450 gpm with 4 ft. of drawdown; water sample taken 5/21/48 while drilling was in progress.

