

STATE ENGINEER  
Salem, Oregon

KLAM  
12421

OBSERVATION WELL  
Well Record

STATE WELL NO. 38/111/2-30M(1)  
COUNTY Klamath  
APPLICATION NO. U-319  
G-4672

OWNER: L. M. & Lloyd Hankins MAILING ADDRESS: Route 1

LOCATION OF WELL: Owner's No. 12 "Pine Flat" CITY AND STATE: Bonanza, Oregon

..... 1/4 ..... 1/4 Sec. .... T. .... N. S., R. .... E. W., W.M.


Bearing and distance from section or subdivision corner N 01° 33' E. 787' from NE cor. Sec. 25, T. 38 S., R. 10 E. Well is actually in

Lot 3, Section 30

Altitude at well 4215

TYPE OF WELL: Drilled Date Constructed

Depth drilled 276? -281 Depth cased

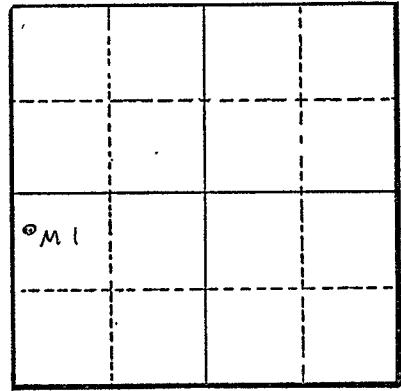

Section 30

CASING RECORD:

16 inch

FINISH:

AQUIFERS:

Broken lava and cinders 223 to 245

WATER LEVEL:

94.42 feet below land surface 4/23/52

PUMPING EQUIPMENT: Type Turbine H.P. Capacity G.P.M.

WELL TESTS:

Drawdown ft. after hours G.P.M.  
Drawdown ft. after hours G.P.M.

USE OF WATER Irrigation Temp. °F., 19

SOURCE OF INFORMATION USGS

DRILLER or DIGGER

ADDITIONAL DATA:  
Log X Water Level Measurements X Chemical Analysis Aquifer Test

REMARKS:

"Pine Flat Well"



STATE ENGINEER  
 Salem, Oregon

State Well No. 38/11 1/2 -30M(1)

County Klamath

Application No. \_\_\_\_\_

### Water Level Record

OWNER: Hankins OWNER'S NO. 12

Description of measuring point: Lip of air line hole in pump base, 300 ft above L.S.D.

Date	Water Level Feet (below) Land Surface	Remarks	Date	Water Level Feet (above) (below) Land Surface	Remarks
4-24-57	93.12				
10-17-57	96.06				
6-4-58	91.86				
10- <del>27</del> <sup>30</sup> -58	93.08	JES			
9-26-61	104.40	WSB AL installed			

REMARKS: \_\_\_\_\_  
 \_\_\_\_\_  
 \_\_\_\_\_