

KLAM 12424


STATE ENGINEER
Salem, Oregon

KLAM **OBSERVATION WELL**
1242A **Well Record**

STATE WELL NO. 38/11½-30R(1)
COUNTY Klamath
APPLICATION NO. U-299

OWNER: W. Hall Mailing ADDRESS: 901 Main Street
CITY AND STATE: Klamath Falls, Oregon
LOCATION OF WELL: Owner's No. 1

SE ¼ SE ¼ Sec. 30 T. 38 N. R. 11½ E., W.M.
Bearing and distance from section or subdivision
corner N. 19° 26' W. 301' from SE cor. Sec. 30

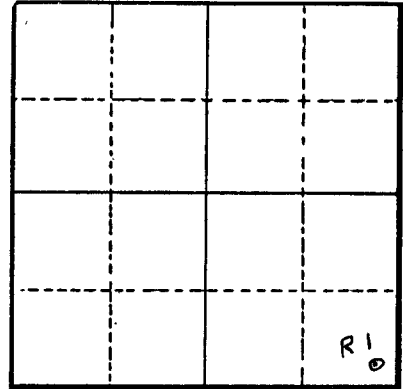

Section 30

Altitude at well 4190

TYPE OF WELL: Drilled Date Constructed _____

Depth drilled 145 Depth cased _____

CASING RECORD:
12 inches

FINISH:

AQUIFERS:

Cinders from 123 to 145 feet

WATER LEVEL:

85' ± below land surface, 1933

PUMPING EQUIPMENT: Type Turbine H.P. _____
Capacity 1,000 G.P.M.

WELL TESTS:

Drawdown _____ ft. after _____ hours _____ G.P.M.
Drawdown _____ ft. after _____ hours _____ G.P.M.

USE OF WATER Irrigation Temp. _____ °F., 19_____

SOURCE OF INFORMATION USGS

DRILLER or DIGGER _____

ADDITIONAL DATA:

Log _____ Water Level Measurements X Chemical Analysis _____ Aquifer Test _____

REMARKS:

Yields 875 gpm

STATE ENGINEER
Salem, Oregon

KLAM OBSERVATION WELL
12424 Well Record


STATE WELL NO. 38/11.5-30R(1)
COUNTY Klamath
APPLICATION NO. U-299

OWNER: W. Hall *GEORGE McCOLLUM* MAILING ADDRESS: 901 Main Street
(Dover House)

LOCATION OF WELL: Owner's No. 1 CITY AND STATE: Klamath Falls, Oregon

SE 1/4 SE 1/4 Sec. 30 T. 38 S., R. 11 1/2 W., W.M.

Bearing and distance from section or subdivision
corner N 19° 26' W. 301' from SE cor. Sec. 30

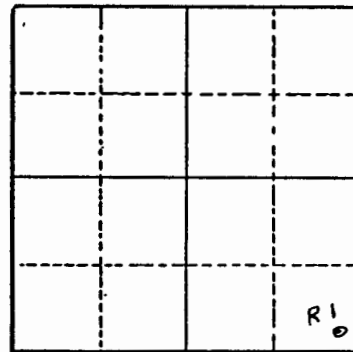

Altitude at well 4190

TYPE OF WELL: Drilled Date Constructed _____

Depth drilled 145 Depth cased _____

Section 30

CASING RECORD:
12 inches

FINISH:

AQUIFERS:

Cinders from 123 to 145 feet

WATER LEVEL:

85' ± below land surface, 1933

PUMPING EQUIPMENT: Type Turbine H.P. _____
Capacity 1,000 G.P.M.

WELL TESTS:

Drawdown _____ ft. after _____ hours _____ G.P.M.
Drawdown _____ ft. after _____ hours _____ G.P.M.

USE OF WATER Irrigation Temp. _____ °F. _____, 19____

SOURCE OF INFORMATION USGS

DRILLER or DIGGER _____

ADDITIONAL DATA:

Log _____ Water Level Measurements _____ Chemical Analysis _____ Aquifer Test _____

REMARKS:

Yields 875 gpm

