

STATE ENGINEER
Salem, Oregon

KLAM
12432

Well Record


STATE WELL NO. 38/111/2-32Q(1)
COUNTY Klamath
APPLICATION NO. U-271

OWNER: L. L. Porterfield MAILING ADDRESS: _____

LOCATION OF WELL: Owner's No. 3 CITY AND STATE: _____

SW 1/4 SE 1/4 Sec. 32 T. 38 N. S., R. 11 1/2 W., W.M.

Bearing and distance from section or subdivision corner 1400' W. & 350' N. from SE cor. Sec. 32

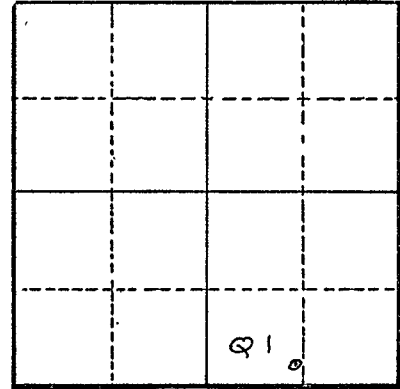

Section 32

Altitude at well _____

TYPE OF WELL: Drilled Date Constructed 1952

Depth drilled 298 Depth cased 20

CASING RECORD:

20 inch set to 57 1/2 feet

FINISH:

open hole

AQUIFERS:

basalt

WATER LEVEL:

72' below land surface

PUMPING EQUIPMENT: Type Turbine H.P. 75
Capacity 2550 G.P.M.

WELL TESTS:

Drawdown 10 ft. after 1/2 hours pumping 2200 G.P.M.
Drawdown 17 ft. after 1 hours pumping 2550 G.P.M.

USE OF WATER Irrigation Temp. °F. 19

SOURCE OF INFORMATION U-271

DRILLER or DIGGER _____

ADDITIONAL DATA:

Log Water Level Measurements _____ Chemical Analysis _____ Aquifer Test _____

REMARKS:

Drawdown 24 feet after 1 1/2 hours pumping 3200 gpm
Drawdown 28' after 2 hours pumping 3800 gpm

