

STATE ENGINEER
Salem, Oregon

KLAMATH
12454

Well Record

STATE WELL NO. 38/11½*34P(1)
COUNTY Klamath
APPLICATION NO. 0209, 11454

OWNER: L. J. Horton


MAILING ADDRESS:

LOCATION OF WELL: Owner's No. 3

CITY AND STATE:

SE ¼ SW ¼ Sec. 34 T. 38 N. S., R. 11½ W., W.M.

Bearing and distance from section or subdivision corner
74° 10' W - 99' from SE
Corner Section 34

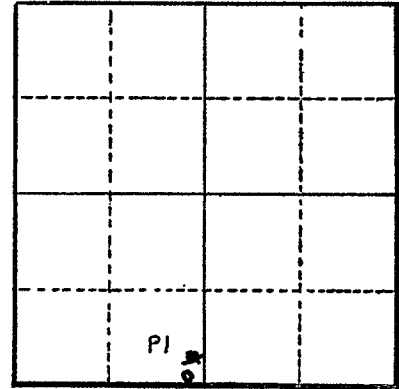

Section 34

Altitude at well 4,121

TYPE OF WELL: Drilled Date Constructed 1949

Depth drilled 55.1 Depth cased

CASING RECORD:
16 inches

FINISH:

AQUIFERS: Broken lava rock and cinder zone from 18 ft. to 57 ft.

WATER LEVEL: 8.55 feet below land surface, July 18, 1949

PUMPING EQUIPMENT: Type Turbine Johnston H.P. 25
Capacity 2800 G.P.M.

WELL TESTS:
Drawdown 3 ft. after hours Pumping between 2500-3000 G.P.M.
Drawdown ft. after hours G.P.M.

USE OF WATER Irrigation Temp. °F., 19

SOURCE OF INFORMATION USGS

DRILLER or DIGGER

ADDITIONAL DATA:
Log * Water Level Measurements Chemical Analysis Aquifer Test

REMARKS: Hardness 50ppm, chloride 4ppm. Test pumped at 3,000 gpm.

