

STATE ENGINEER
Salem, Oregon

KLAM
12457

Well Record

STATE WELL NO 38/11 $\frac{1}{2}$ -36D(1) *bba*
COUNTY Klamath
APPLICATION NO. U281 - Conc. 11.1
G-3906 appl.
G-3670 Permit

OWNER: R. Hoeffler


MAILING ADDRESS: _____
CITY AND STATE: _____

LOCATION OF WELL: Owner's No. _____
NW NW 36 38 M. 11 $\frac{1}{2}$ E.
_____ $\frac{1}{4}$ _____ $\frac{1}{4}$ Sec. _____ T. _____ S., R. _____ W., W.M.

Bearing and distance from section or subdivision corner _____

Altitude at well 4,158

TYPE OF WELL: Drilled Date Constructed _____
Depth drilled 470 Depth cased _____

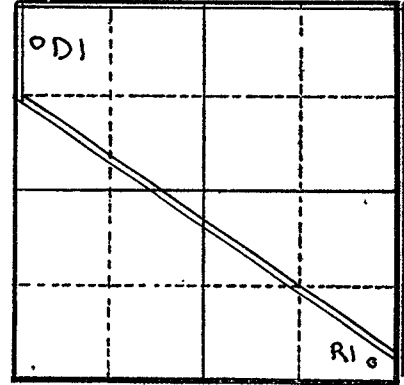

Section 36

CASING RECORD: 18 inches

FINISH: _____

AQUIFERS: _____

WATER LEVEL: 45.66 feet below land surface, August 22, 1949

PUMPING EQUIPMENT: Type _____ H.P. _____
Capacity _____ G.P.M.

WELL TESTS:
Drawdown _____ ft. after _____ hours _____ G.P.M.
Drawdown _____ ft. after _____ hours _____ G.P.M.

USE OF WATER Irrigation Temp. _____ °F. _____, 19____

SOURCE OF INFORMATION USGS U281 - Conc. 11.1

DRILLER or DIGGER _____
ADDITIONAL DATA:

Log _____ Water Level Measurements _____ Chemical Analysis _____ Aquifer Test _____

REMARKS: Hardness 225ppm, chloride 9ppm. Drilled for oil prospect; 30-in. hole to 1,580 ft.; now cleaned out to 470 foot depth; reported yield 1,500 gpm; chemical tests made on a dipped sample.