

STATE ENGINEER
Salem, Oregon

KLAM 12549

Well Record

STATE WELL NO. 39/9-7H1
COUNTY Klamath
APPLICATION NO.

OWNER: W. T. Mann


MAILING
ADDRESS:

LOCATION OF WELL: Owner's No.

CITY AND
STATE:

..... 1/4 1/4 Sec. T. N. E.
S, R. W., W.M.

Bearing and distance from section or subdivision
corner

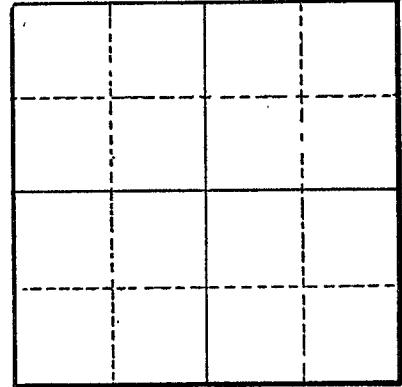

Section

Altitude at well 4,225

TYPE OF WELL: Drilled Date Constructed

Depth drilled 250 Depth cased 250?

CASING RECORD:
4 inch

FINISH:

AQUIFERS:

Basalt

WATER LEVEL:

60 feet below land surface, July, 1950

PUMPING EQUIPMENT: Type Submersible turbine H.P.
Capacity 20 G.P.M.

WELL TESTS:

Drawdown ft. after hours G.P.M.
Drawdown ft. after hours G.P.M.

USE OF WATER Domestic Temp. °F., 19.....

SOURCE OF INFORMATION USGS

DRILLER or DIGGER

ADDITIONAL DATA:

Log Water Level Measurements Chemical Analysis Aquifer Test

REMARKS:

Supplies motel; owner has similar well 120 ft. to the south.